

**FRONT STREET VILLAGE
DRYSTACK 1
BEAUFORT, NORTH CAROLINA**


16015

ISSUED: 31 MAY 16
DWG BY: MLR
CKD BY: LDD
REVISIONS

SHEET NO.
1
OF

MATCHLINE B
MATCHLINE B

MATCHLINE A
MATCHLINE A

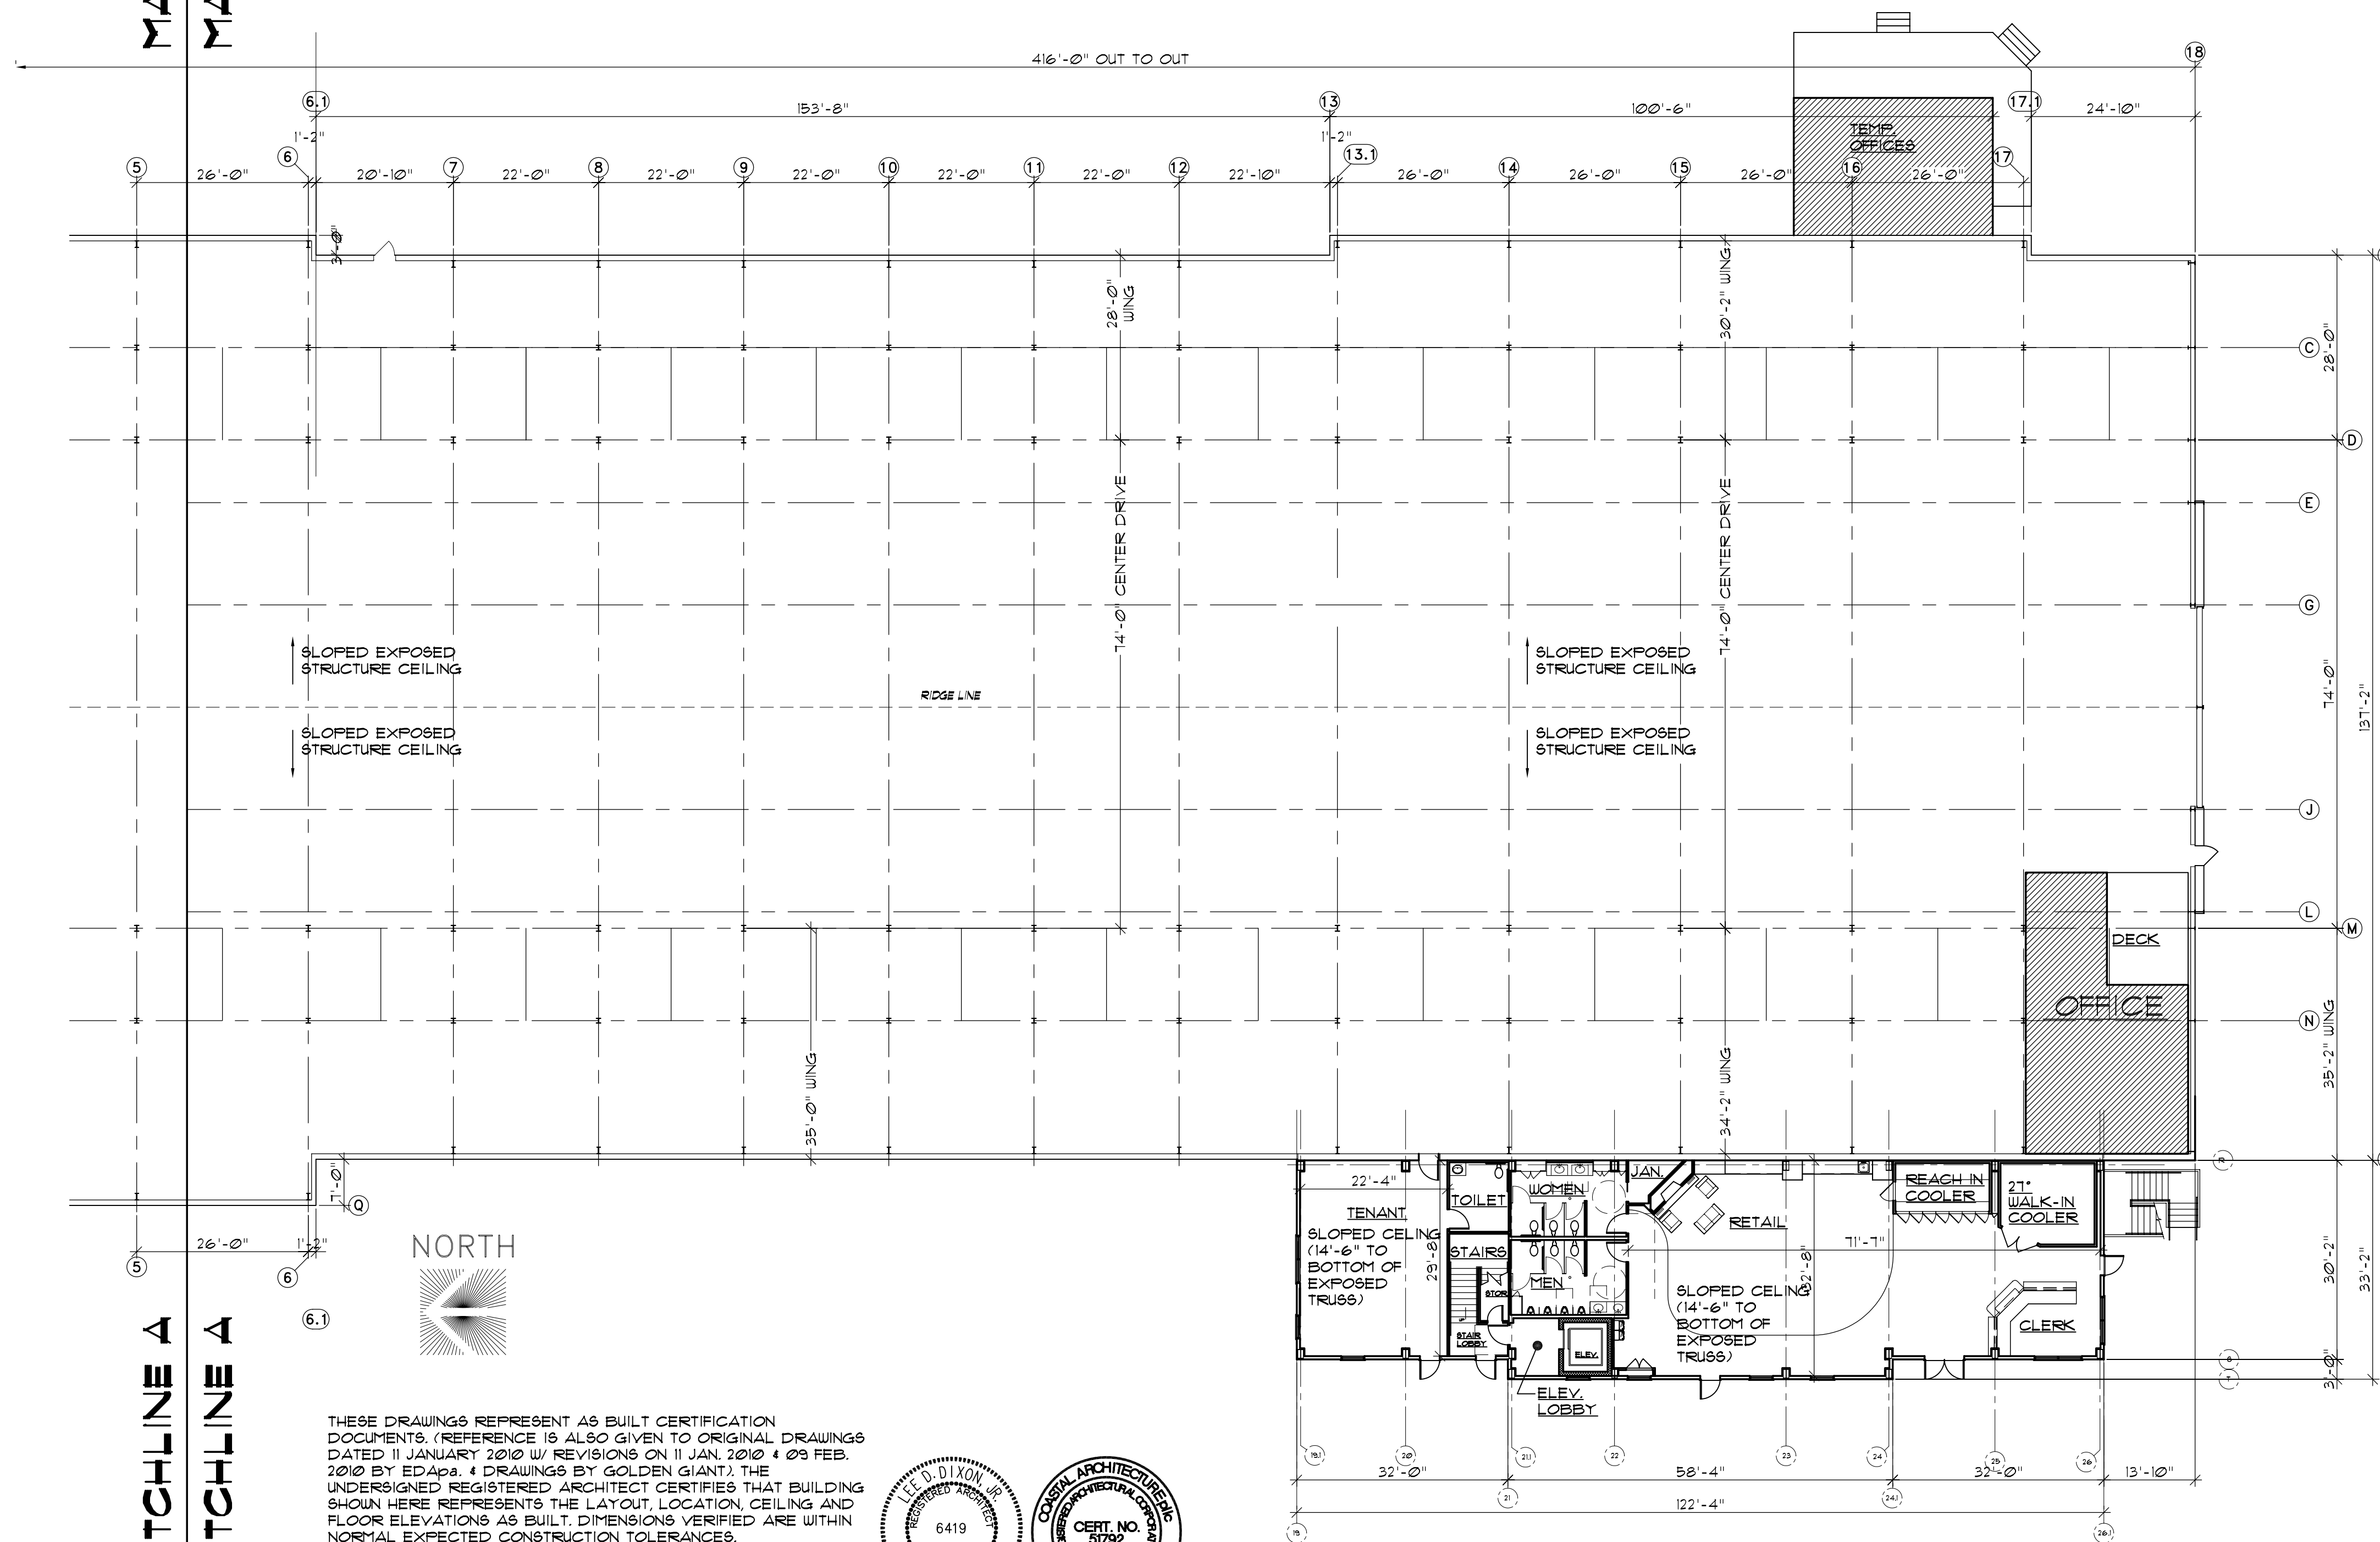

THESE DRAWINGS REPRESENT AS BUILT CERTIFICATION DOCUMENTS. (REFERENCE IS ALSO GIVEN TO ORIGINAL DRAWINGS DATED 11 JANUARY 2010 W/ REVISIONS ON 11 JAN. 2010 & 09 FEB. 2010 BY EDAPA. 4 DRAWINGS BY GOLDEN GIANT). THE UNDERSIGNED REGISTERED ARCHITECT CERTIFIES THAT BUILDING SHOWN HERE REPRESENTS THE LAYOUT, LOCATION, CEILING AND FLOOR ELEVATIONS AS BUILT. DIMENSIONS VERIFIED ARE WITHIN NORMAL EXPECTED CONSTRUCTION TOLERANCES.



LEE D. DIXON, JR., AIA
COASTAL ARCHITECTURE PLLC

1ST LEVEL FLOOR PLAN
SCALE: 1/16" = 1'-0"

**FRONT STREET VILLAGE
DRYSTACK 1
BEAUFORT, NORTH CAROLINA**

16015

ISSUED: 31 MAY 16


DWG BY: MLR

CKD BY: LDD


REVISIONS

SHEET NO.

1.1
OF


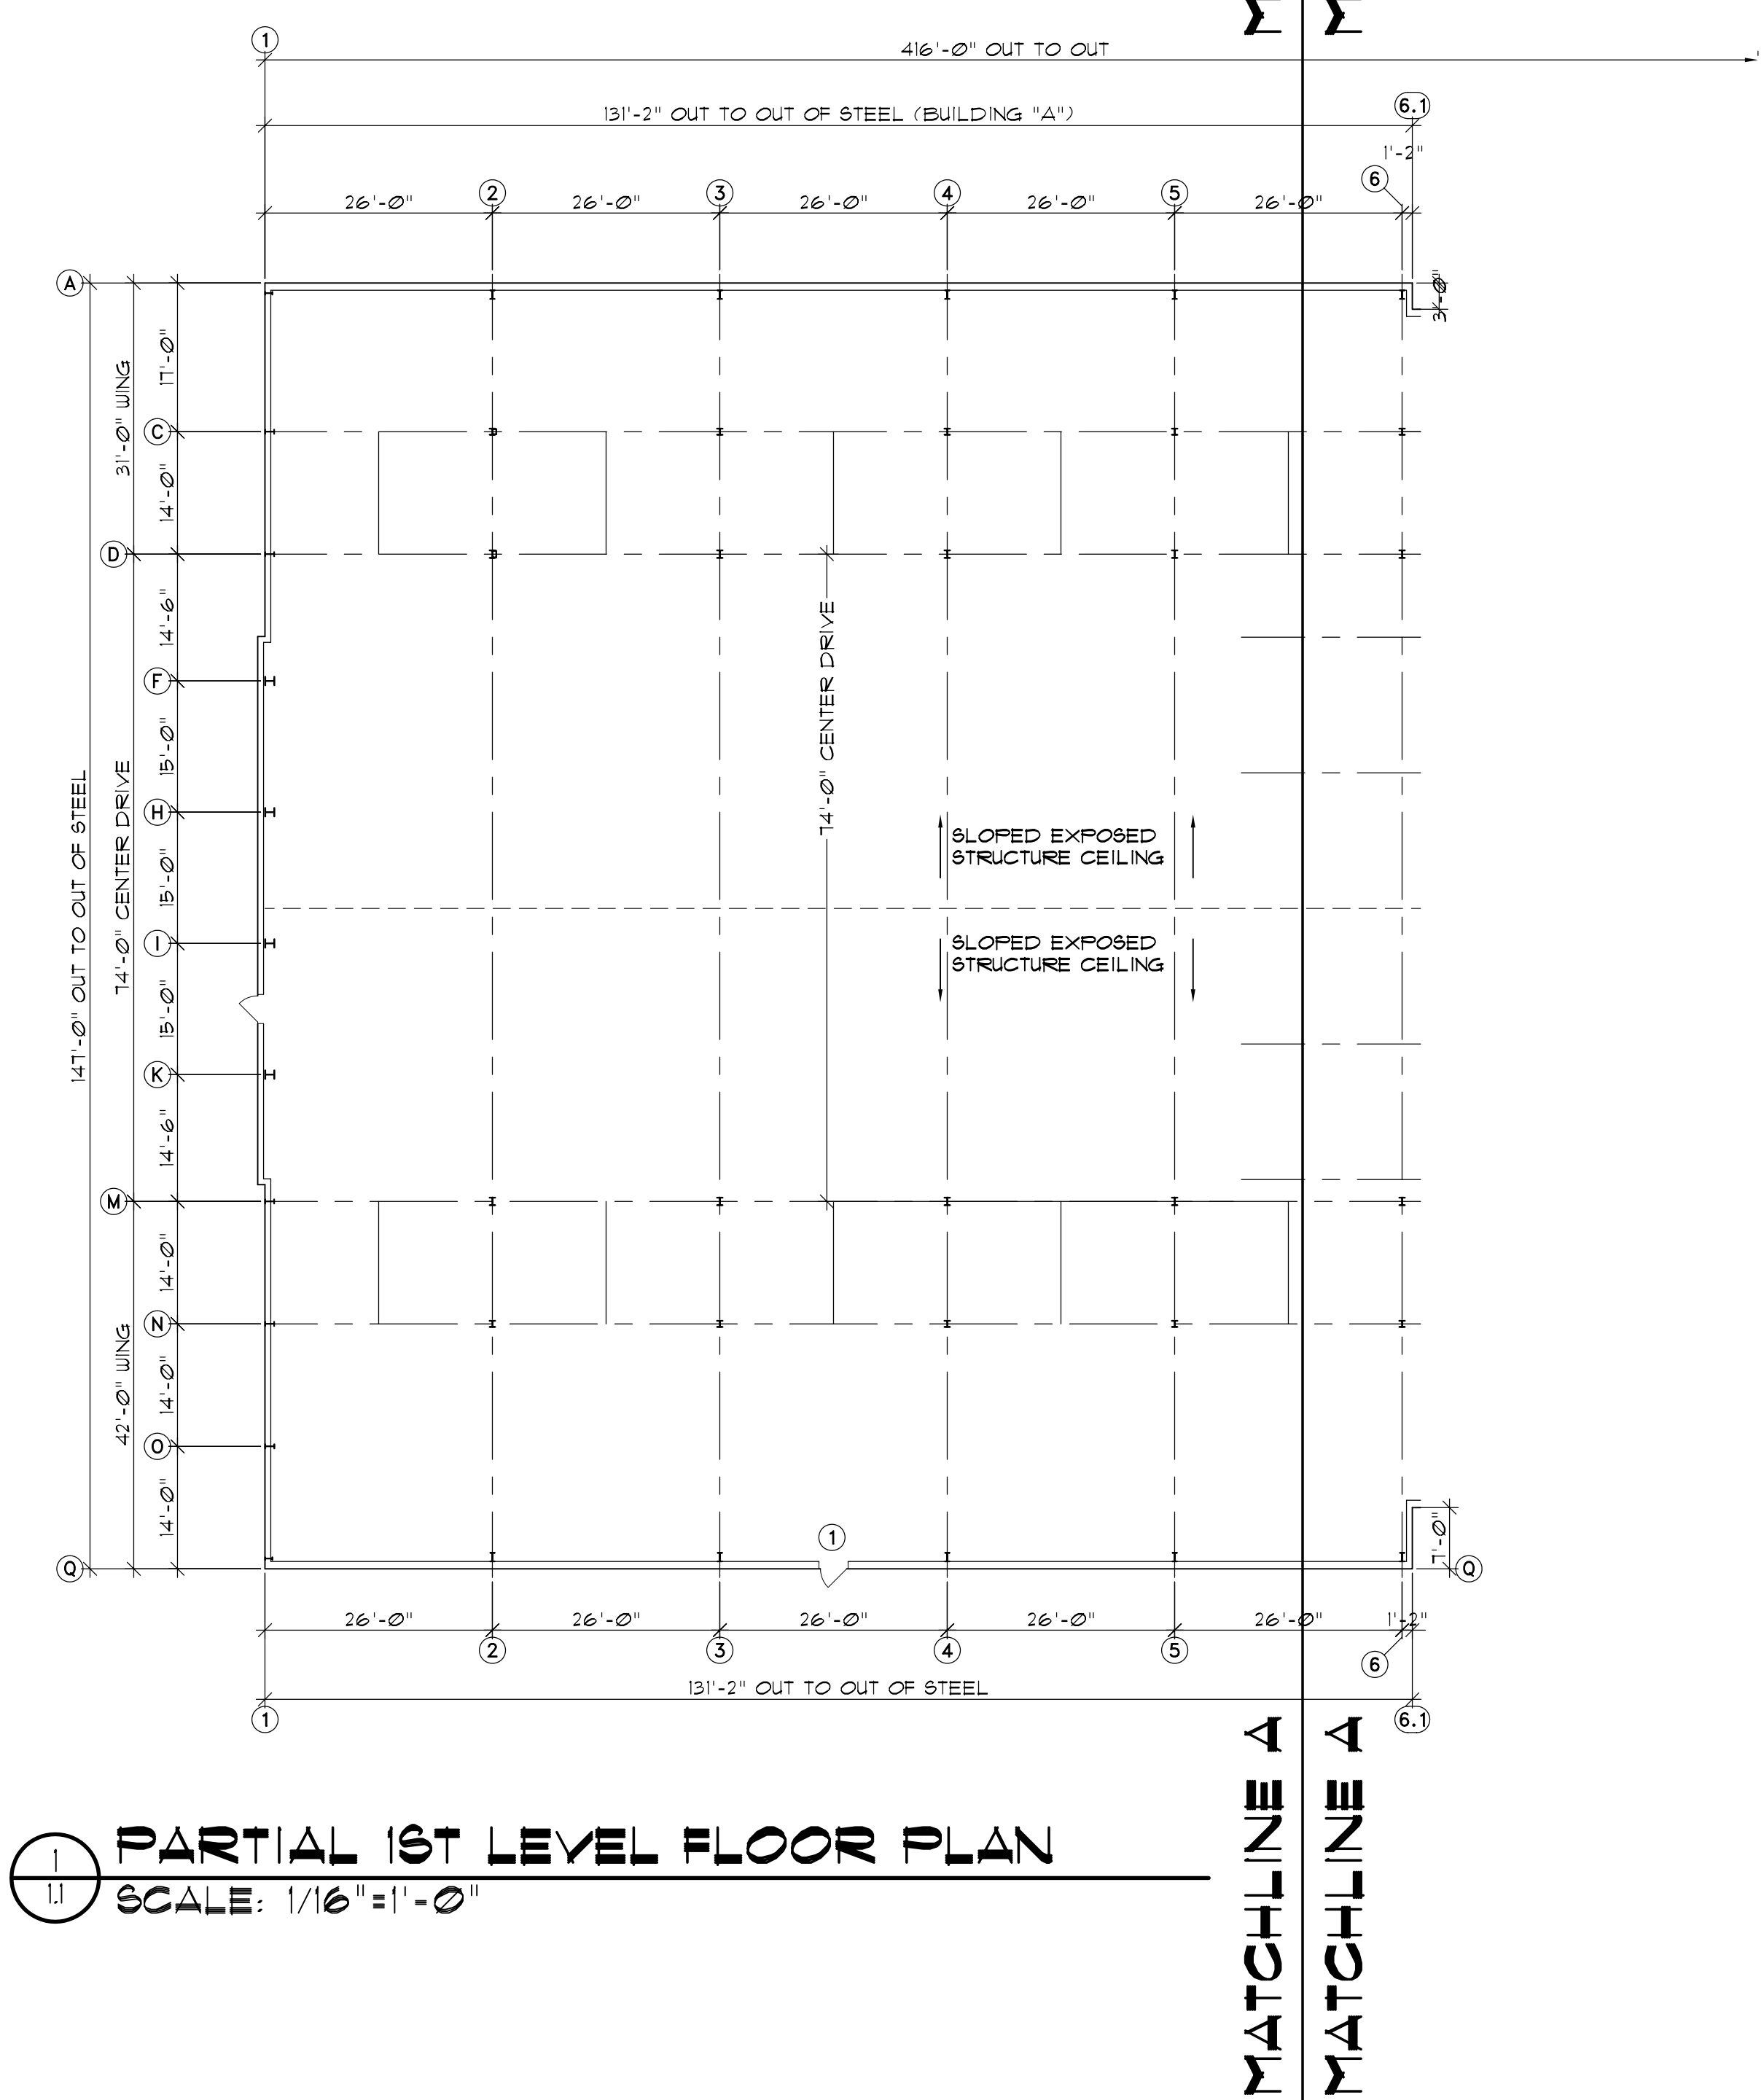


PARTIAL 1ST LEVEL FLOOR PLAN
SCALE: 1/16" = 1'-0"

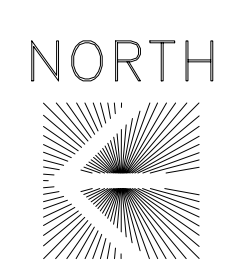

THESE DRAWINGS REPRESENT AS BUILT CERTIFICATION DOCUMENTS. (REFERENCE IS ALSO GIVEN TO ORIGINAL DRAWINGS DATED 11 JANUARY 2010 W/ REVISIONS ON 11 JAN. 2010 & 09 FEB. 2010 BY EDAPA. & DRAWINGS BY GOLDEN GIANT.) THE UNDERSIGNED REGISTERED ARCHITECT CERTIFIES THAT BUILDING SHOWN HERE REPRESENTS THE LAYOUT, LOCATION, CEILING AND FLOOR ELEVATIONS AS BUILT. DIMENSIONS VERIFIED ARE WITHIN NORMAL EXPECTED CONSTRUCTION TOLERANCES.


LEE D. DIXON JR., AIA
COASTAL ARCHITECTURE PLLC

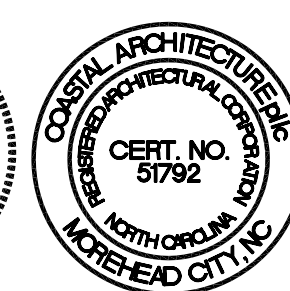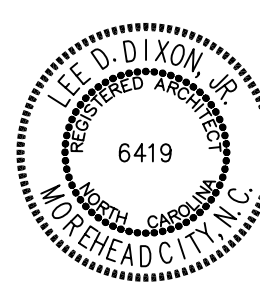

MATCHLINE B
MATCHLINE B




MATCHLINE A
MATCHLINE A

SEE SHEET 11

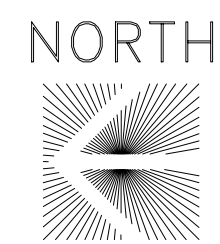



THESE DRAWINGS REPRESENT AS BUILT CERTIFICATION DOCUMENTS. (REFERENCE IS ALSO GIVEN TO ORIGINAL DRAWINGS DATED 11 JANUARY 2010 W/ REVISIONS ON 11 JAN. 2010 & 09 FEB. 2010 BY EDAPA, & DRAWINGS BY GOLDEN GIANT). THE UNDERSIGNED REGISTERED ARCHITECT CERTIFIES THAT BUILDING SHOWN HERE REPRESENTS THE LAYOUT, LOCATION, CEILING AND FLOOR ELEVATIONS AS BUILT. DIMENSIONS VERIFIED ARE WITHIN NORMAL EXPECTED CONSTRUCTION TOLERANCES.

LEE D. DIXON JR., AIA
COASTAL ARCHITECTURE PLLC

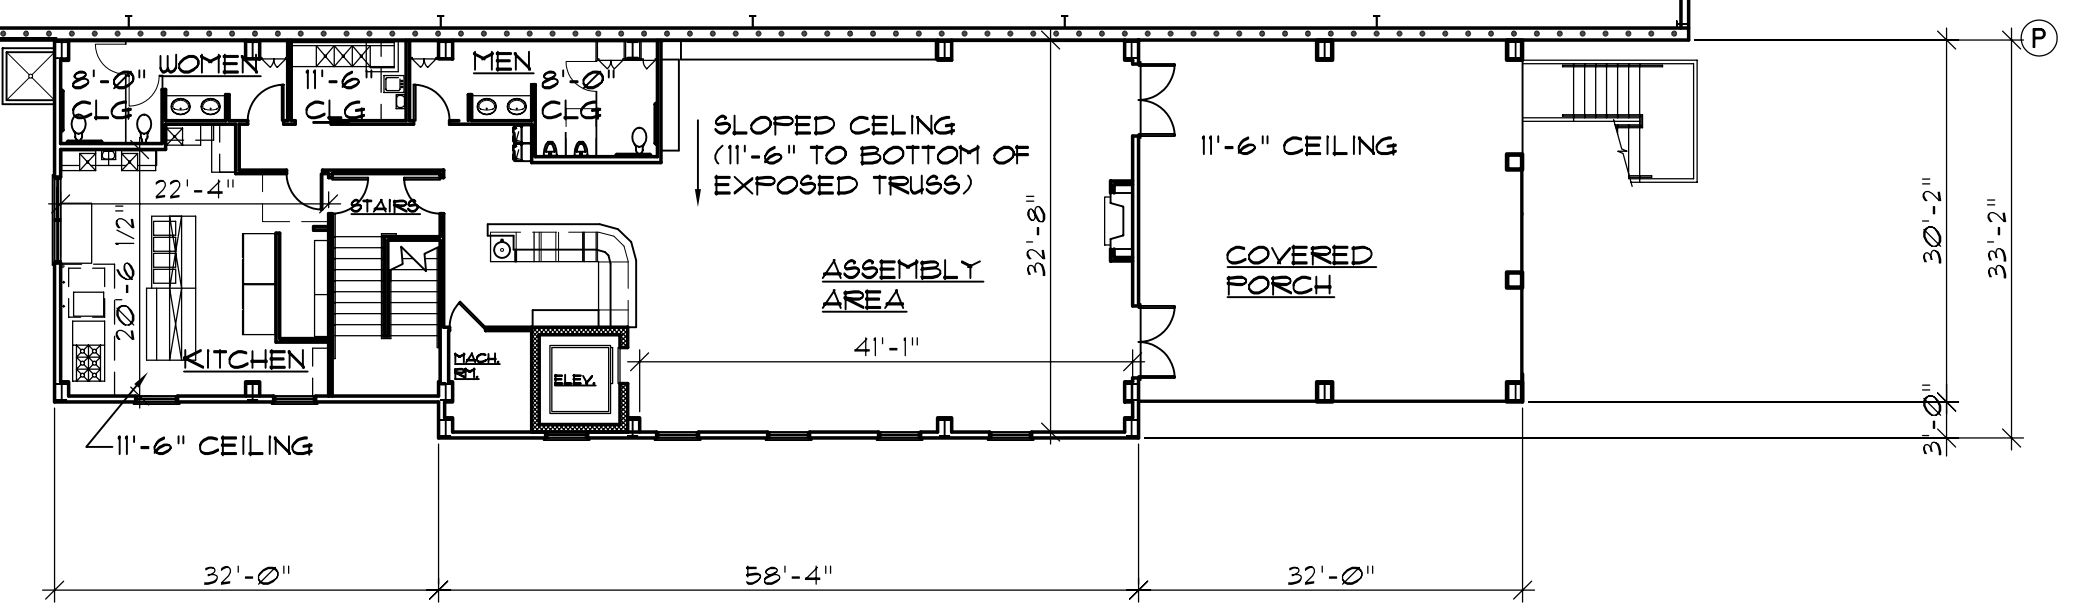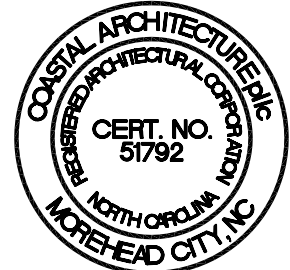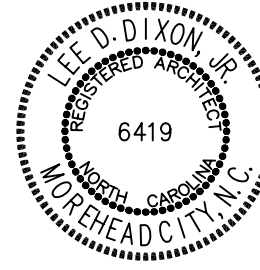


1 2ND LEVEL FLOOR PLAN
2 SCALE: 1/16" = 1'-0"


THESE DRAWINGS REPRESENT AS BUILT CERTIFICATION DOCUMENTS. (REFERENCE IS ALSO GIVEN TO ORIGINAL DRAWINGS DATED 11 JANUARY 2010 W/ REVISIONS ON 11 JAN. 2010 & 09 FEB. 2010 BY EDAPA. & DRAWINGS BY GOLDEN GIANT). THE UNDERSIGNED REGISTERED ARCHITECT CERTIFIES THAT BUILDING SHOWN HERE REPRESENTS THE LAYOUT, LOCATION, CEILING AND FLOOR ELEVATIONS AS BUILT. DIMENSIONS VERIFIED ARE WITHIN NORMAL EXPECTED CONSTRUCTION TOLERANCES.

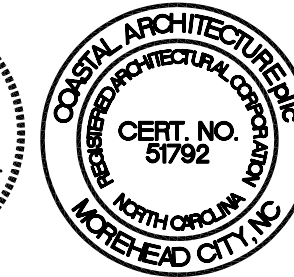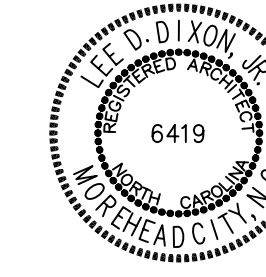


LEE D. DIXON JR., AIA
COASTAL ARCHITECTURE, P.C.

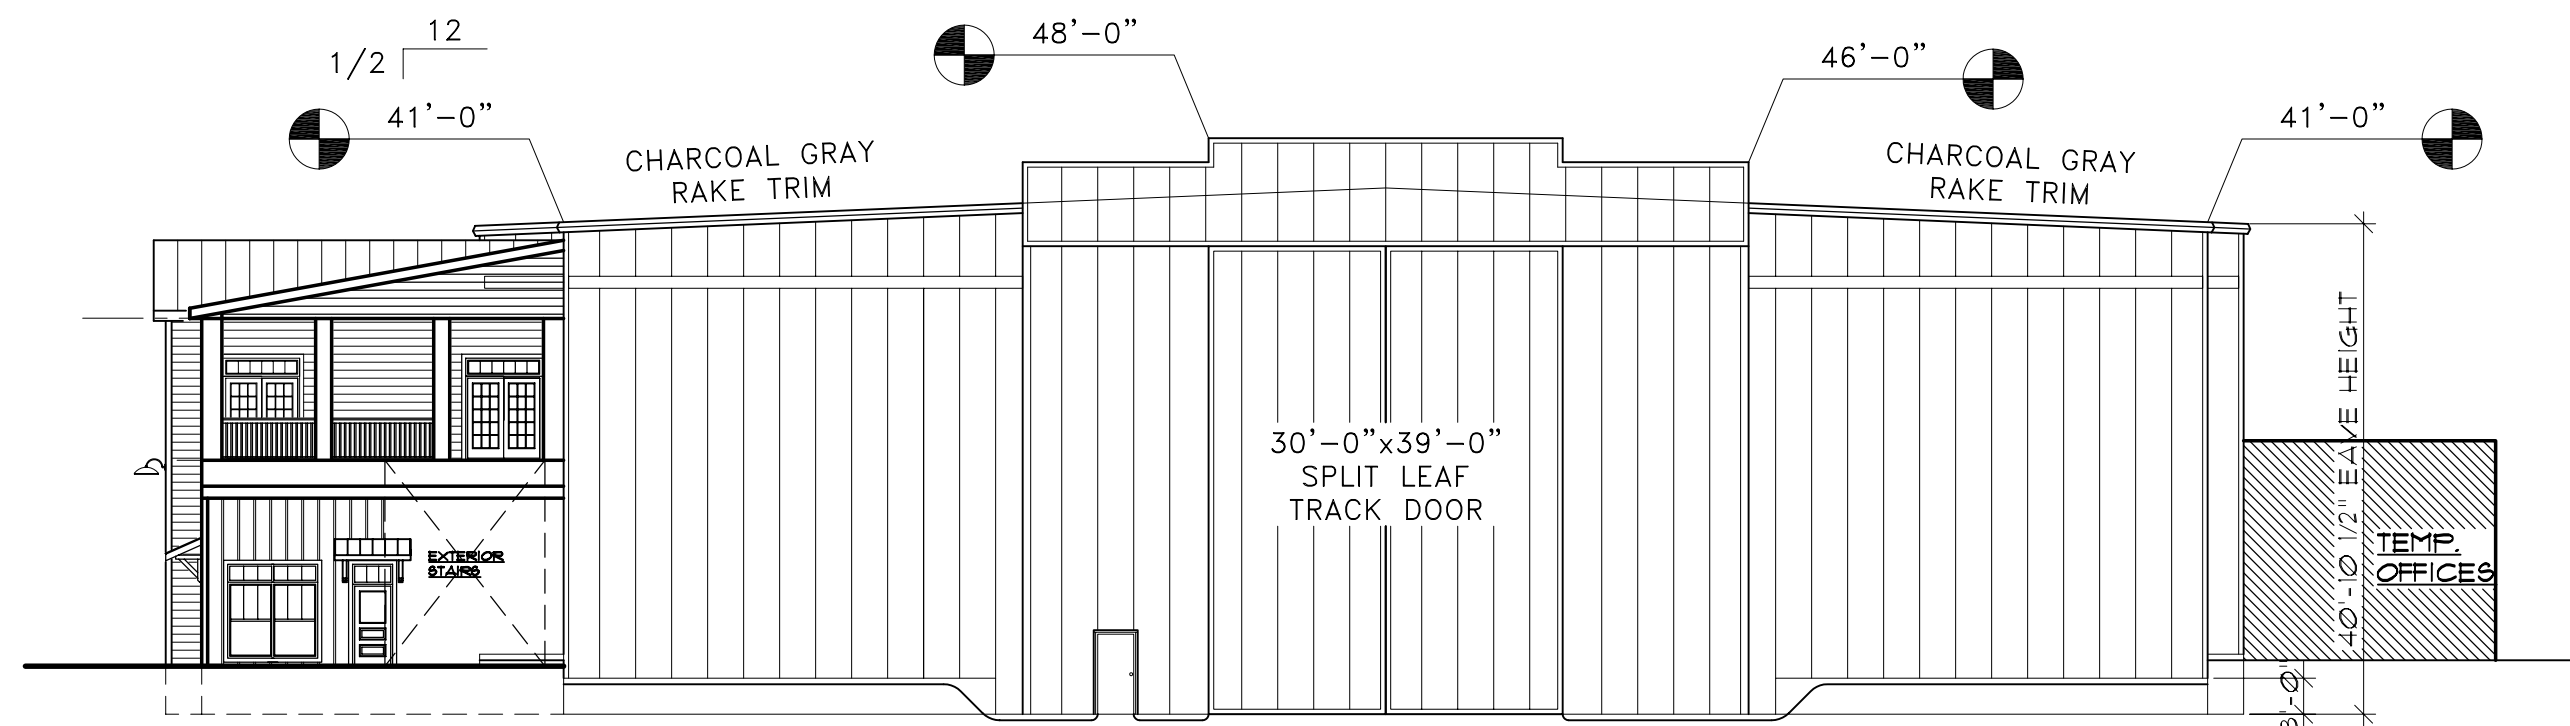


3 SOUTH ELEVATION
SCALE: 1/16" = 1'-0"

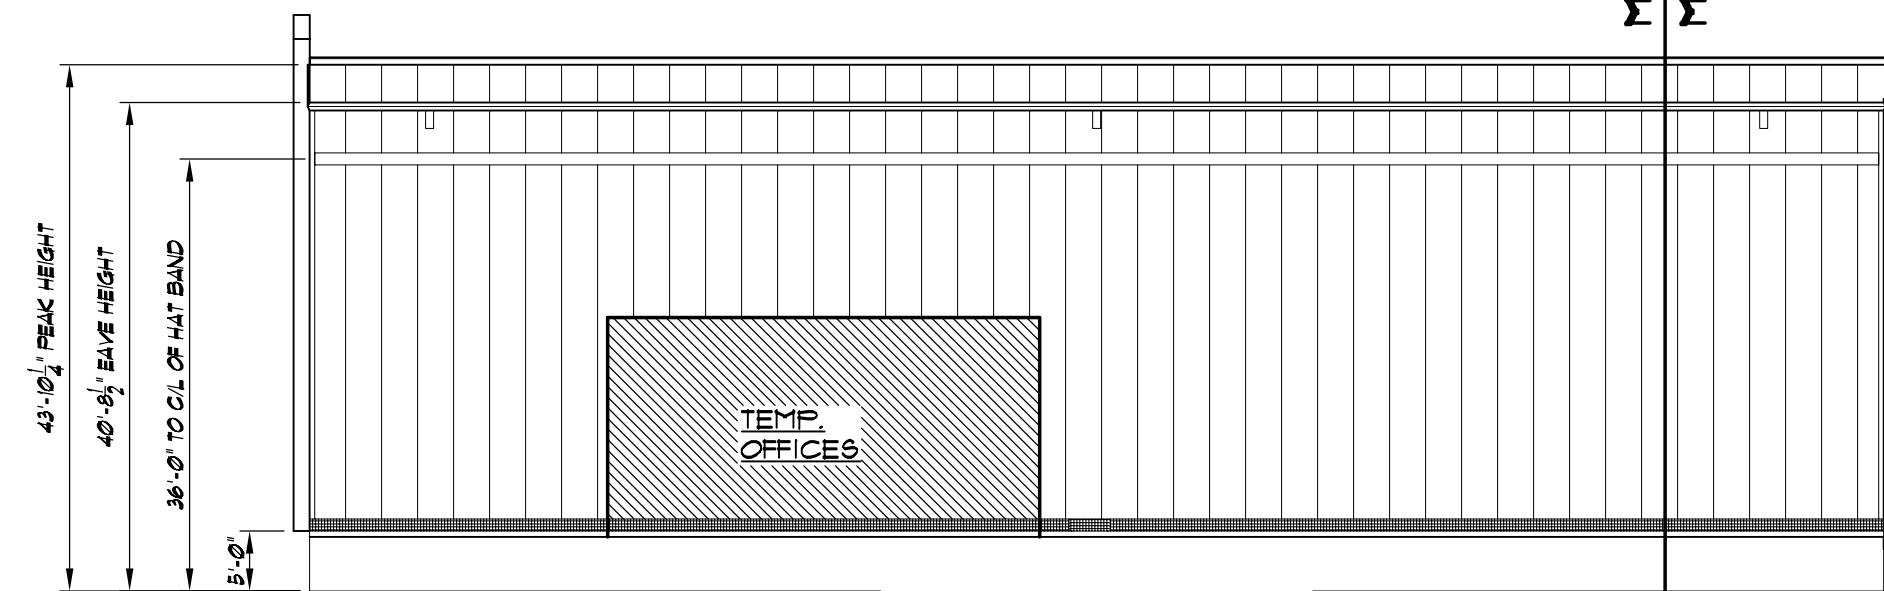

2 PARTAIL WEST SIDEWALL ELEVATION
SCALE: 1/16" = 1'-0"

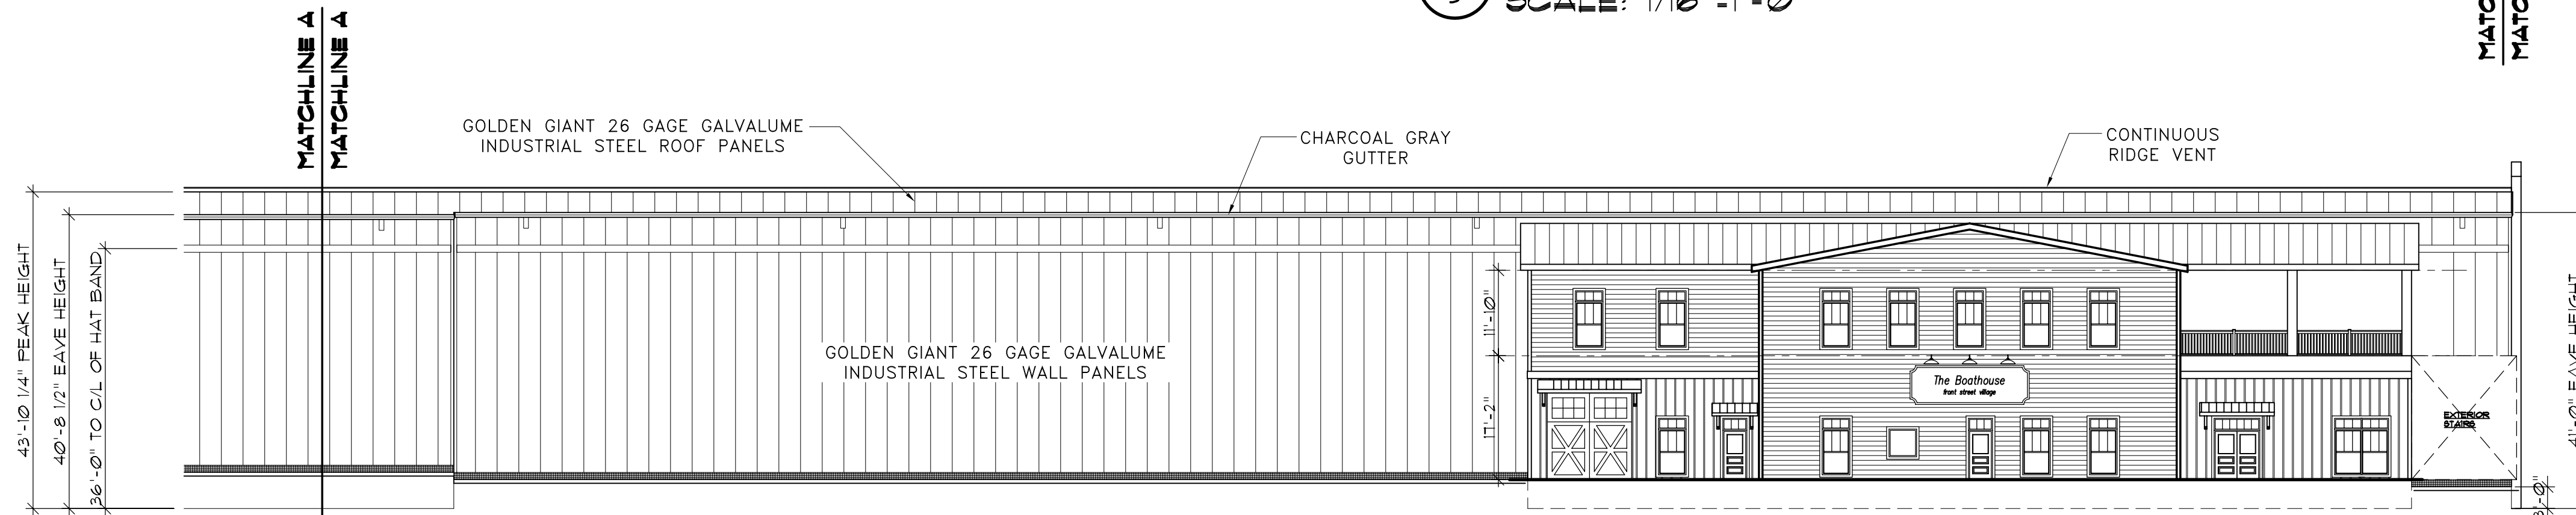


1 PARTAIL WEST SIDEWALL ELEVATION
SCALE: 1/16" = 1'-0"

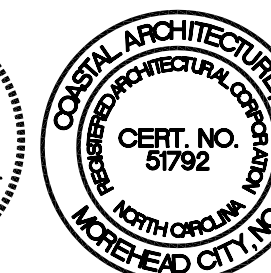


THESE DRAWINGS REPRESENT AS BUILT CERTIFICATION DOCUMENTS. (REFERENCE IS ALSO GIVEN TO ORIGINAL DRAWINGS DATED 11 JANUARY 2010 W/ REVISIONS ON 11 JAN. 2010 & 09 FEB. 2010 BY EDAPA. & DRAWINGS BY GOLDEN GIANT). THE UNDERSIGNED REGISTERED ARCHITECT CERTIFIES THAT BUILDING SHOWN HERE REPRESENTS THE LAYOUT, LOCATION, CEILING AND FLOOR ELEVATIONS AS BUILT. DIMENSIONS VERIFIED ARE WITHIN NORMAL EXPECTED CONSTRUCTION TOLERANCES.


LEE D. DIXON JR., AIA
COASTAL ARCHITECTURE, PLLC

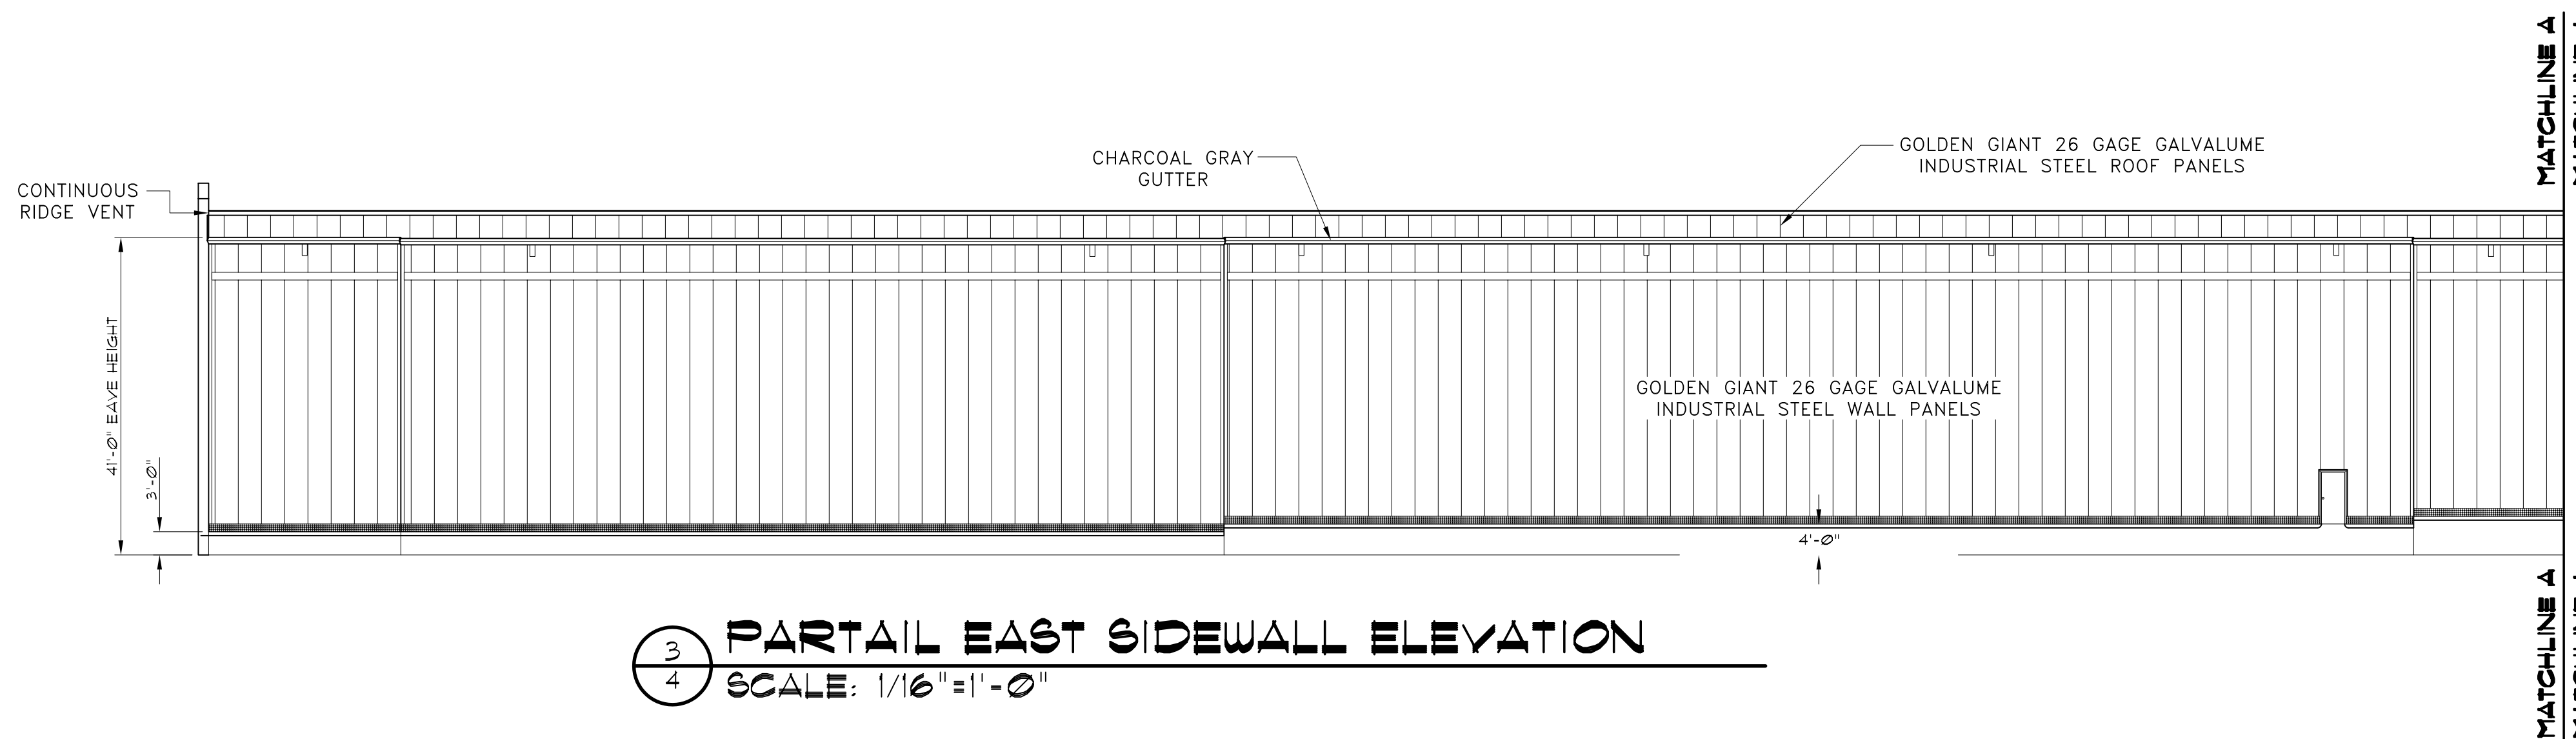

3 PARTIAL EAST SIDEWALL ELEVATION
4 SCALE: 1/16" = 1'-0"

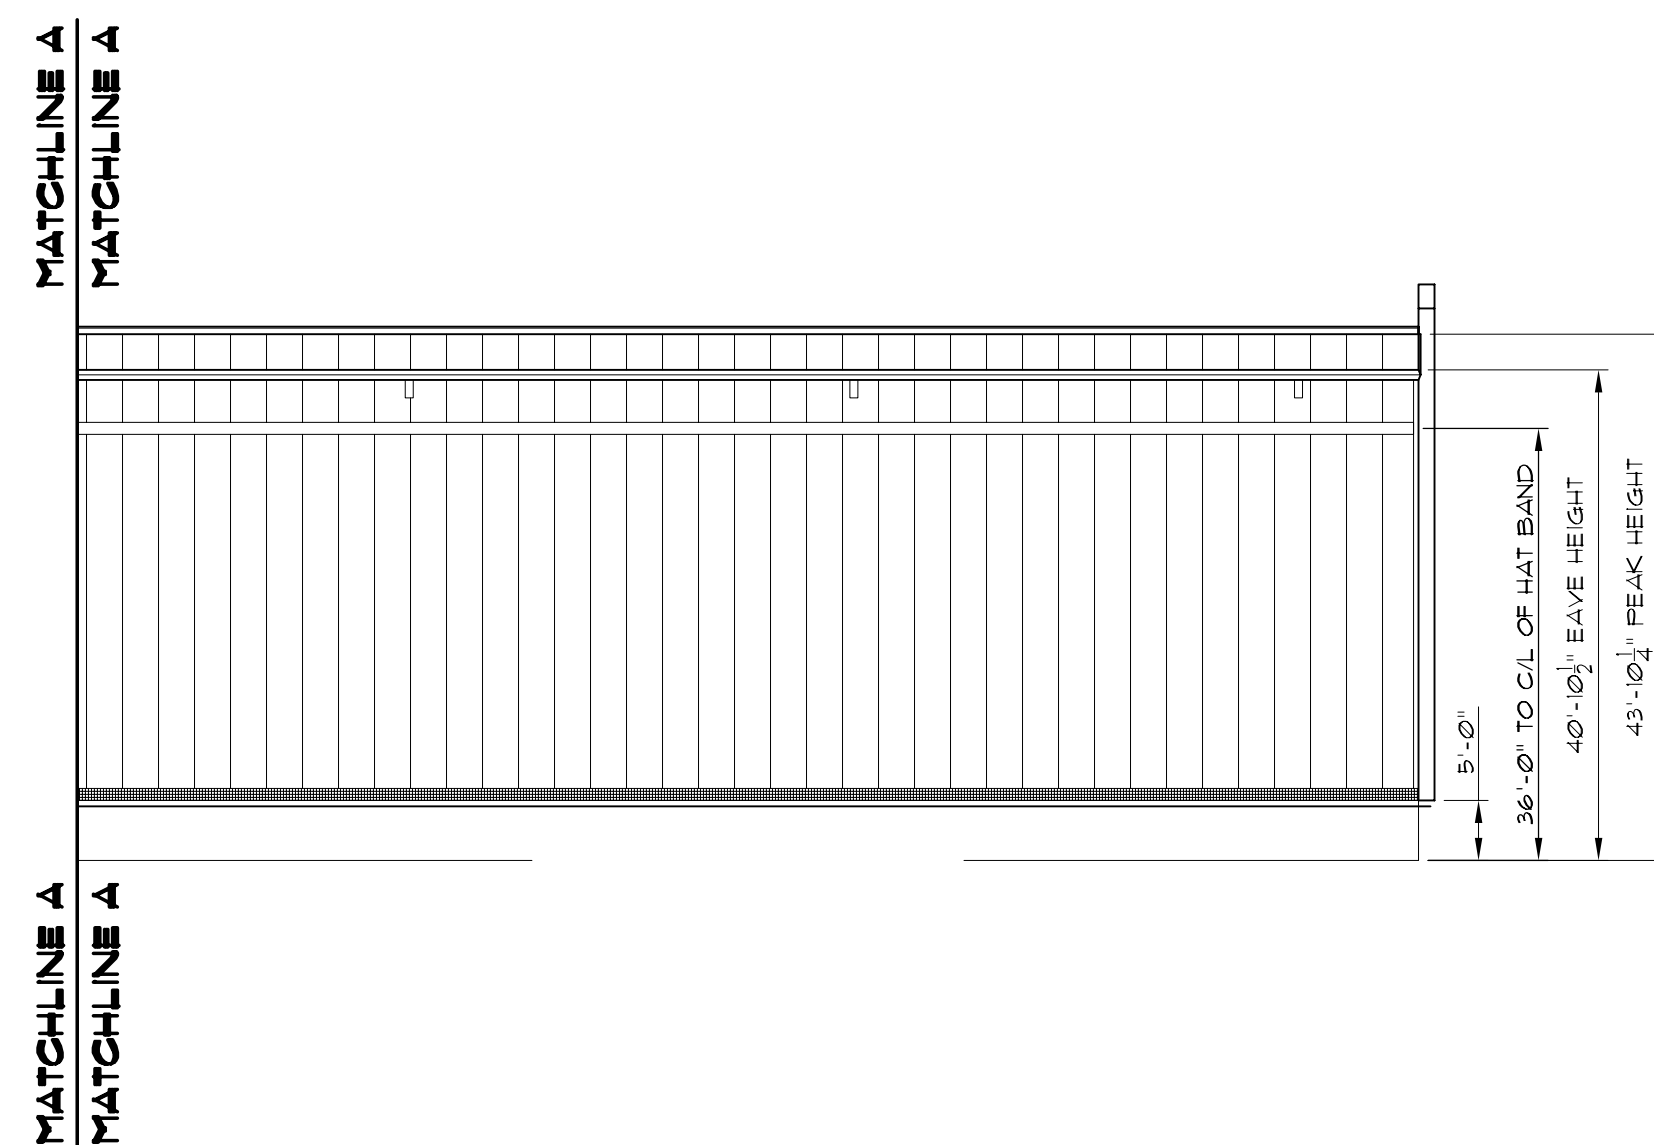

2 PARTIAL EAST SIDEWALL ELEVATION
4 SCALE: 1/16" = 1'-0"

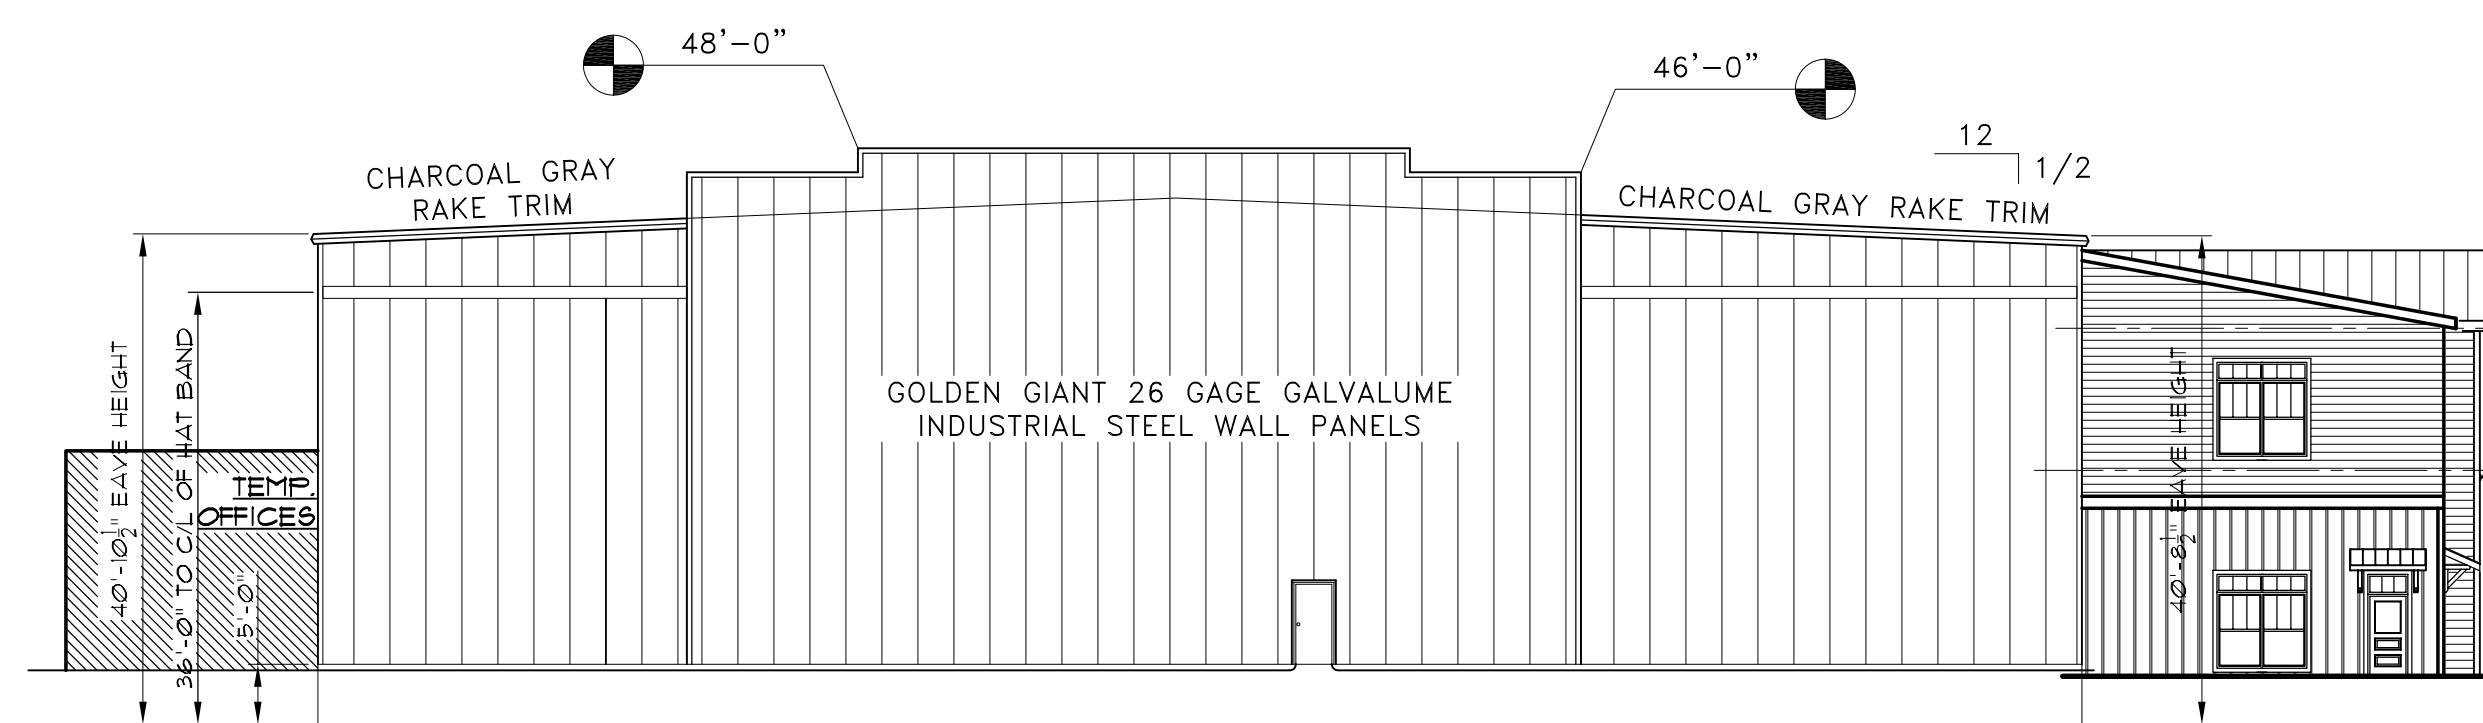

1 NORTH ENDWALL ELEVATION
4 SCALE: 1/16" = 1'-0"

FRONT STREET VILLAGE
DRYSTACK 1
BEAUFORT, NORTH CAROLINA

16015

ISSUED: 31 MAY 16
DWG BY: MLR
CKD BY: LDD
REVISIONS

SHEET NO.
4
OF