


THESE DRAWINGS REPRESENT CONDO CERTIFICATION DOCUMENTS. (REFERENCE IS ALSO GIVEN TO ORIGINAL DRAWINGS DATED 15 SEPT. 14 BY COASTAL ARCHITECTURE.) THE UNDERSIGNED REGISTERED ARCHITECT CERTIFIES THAT BUILDING UNITS SHOWN HERE REPRESENTS THE LAYOUT, LOCATION, CEILING AND FLOOR ELEVATIONS, UNIT NUMBERS AND DIMENSIONS OF THE UNITS AS BUILT. DIMENSIONS VERIFIED ARE WITHIN NORMAL EXPECTED CONSTRUCTION TOLERANCES. IT IS FURTHER STATED THAT SUCH PLANS CONTAIN THE INFORMATION REQUIRED BY NCGS 41C-2-109.

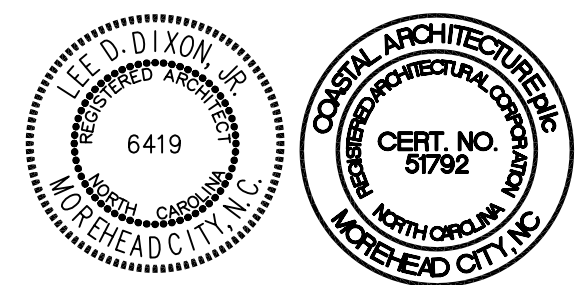


LEE D. DIXON, JR., AIA  
COASTAL ARCHITECTURE PLLC

**Coastal**  
Architecture  
Architectural  
Design

Lee D. Dixon, Jr., AIA  
252-247-2127  
lee@coastalarchitecture.net


4206 Bridges St. Ext.,  
Suite C  
Morehead City, NC  
28557

**FRONT STREET VILLAGE PHASE II**  
**'LIGHT KEEPER'S COTTAGE'**  
BEAUFORT, NORTH CAROLINA

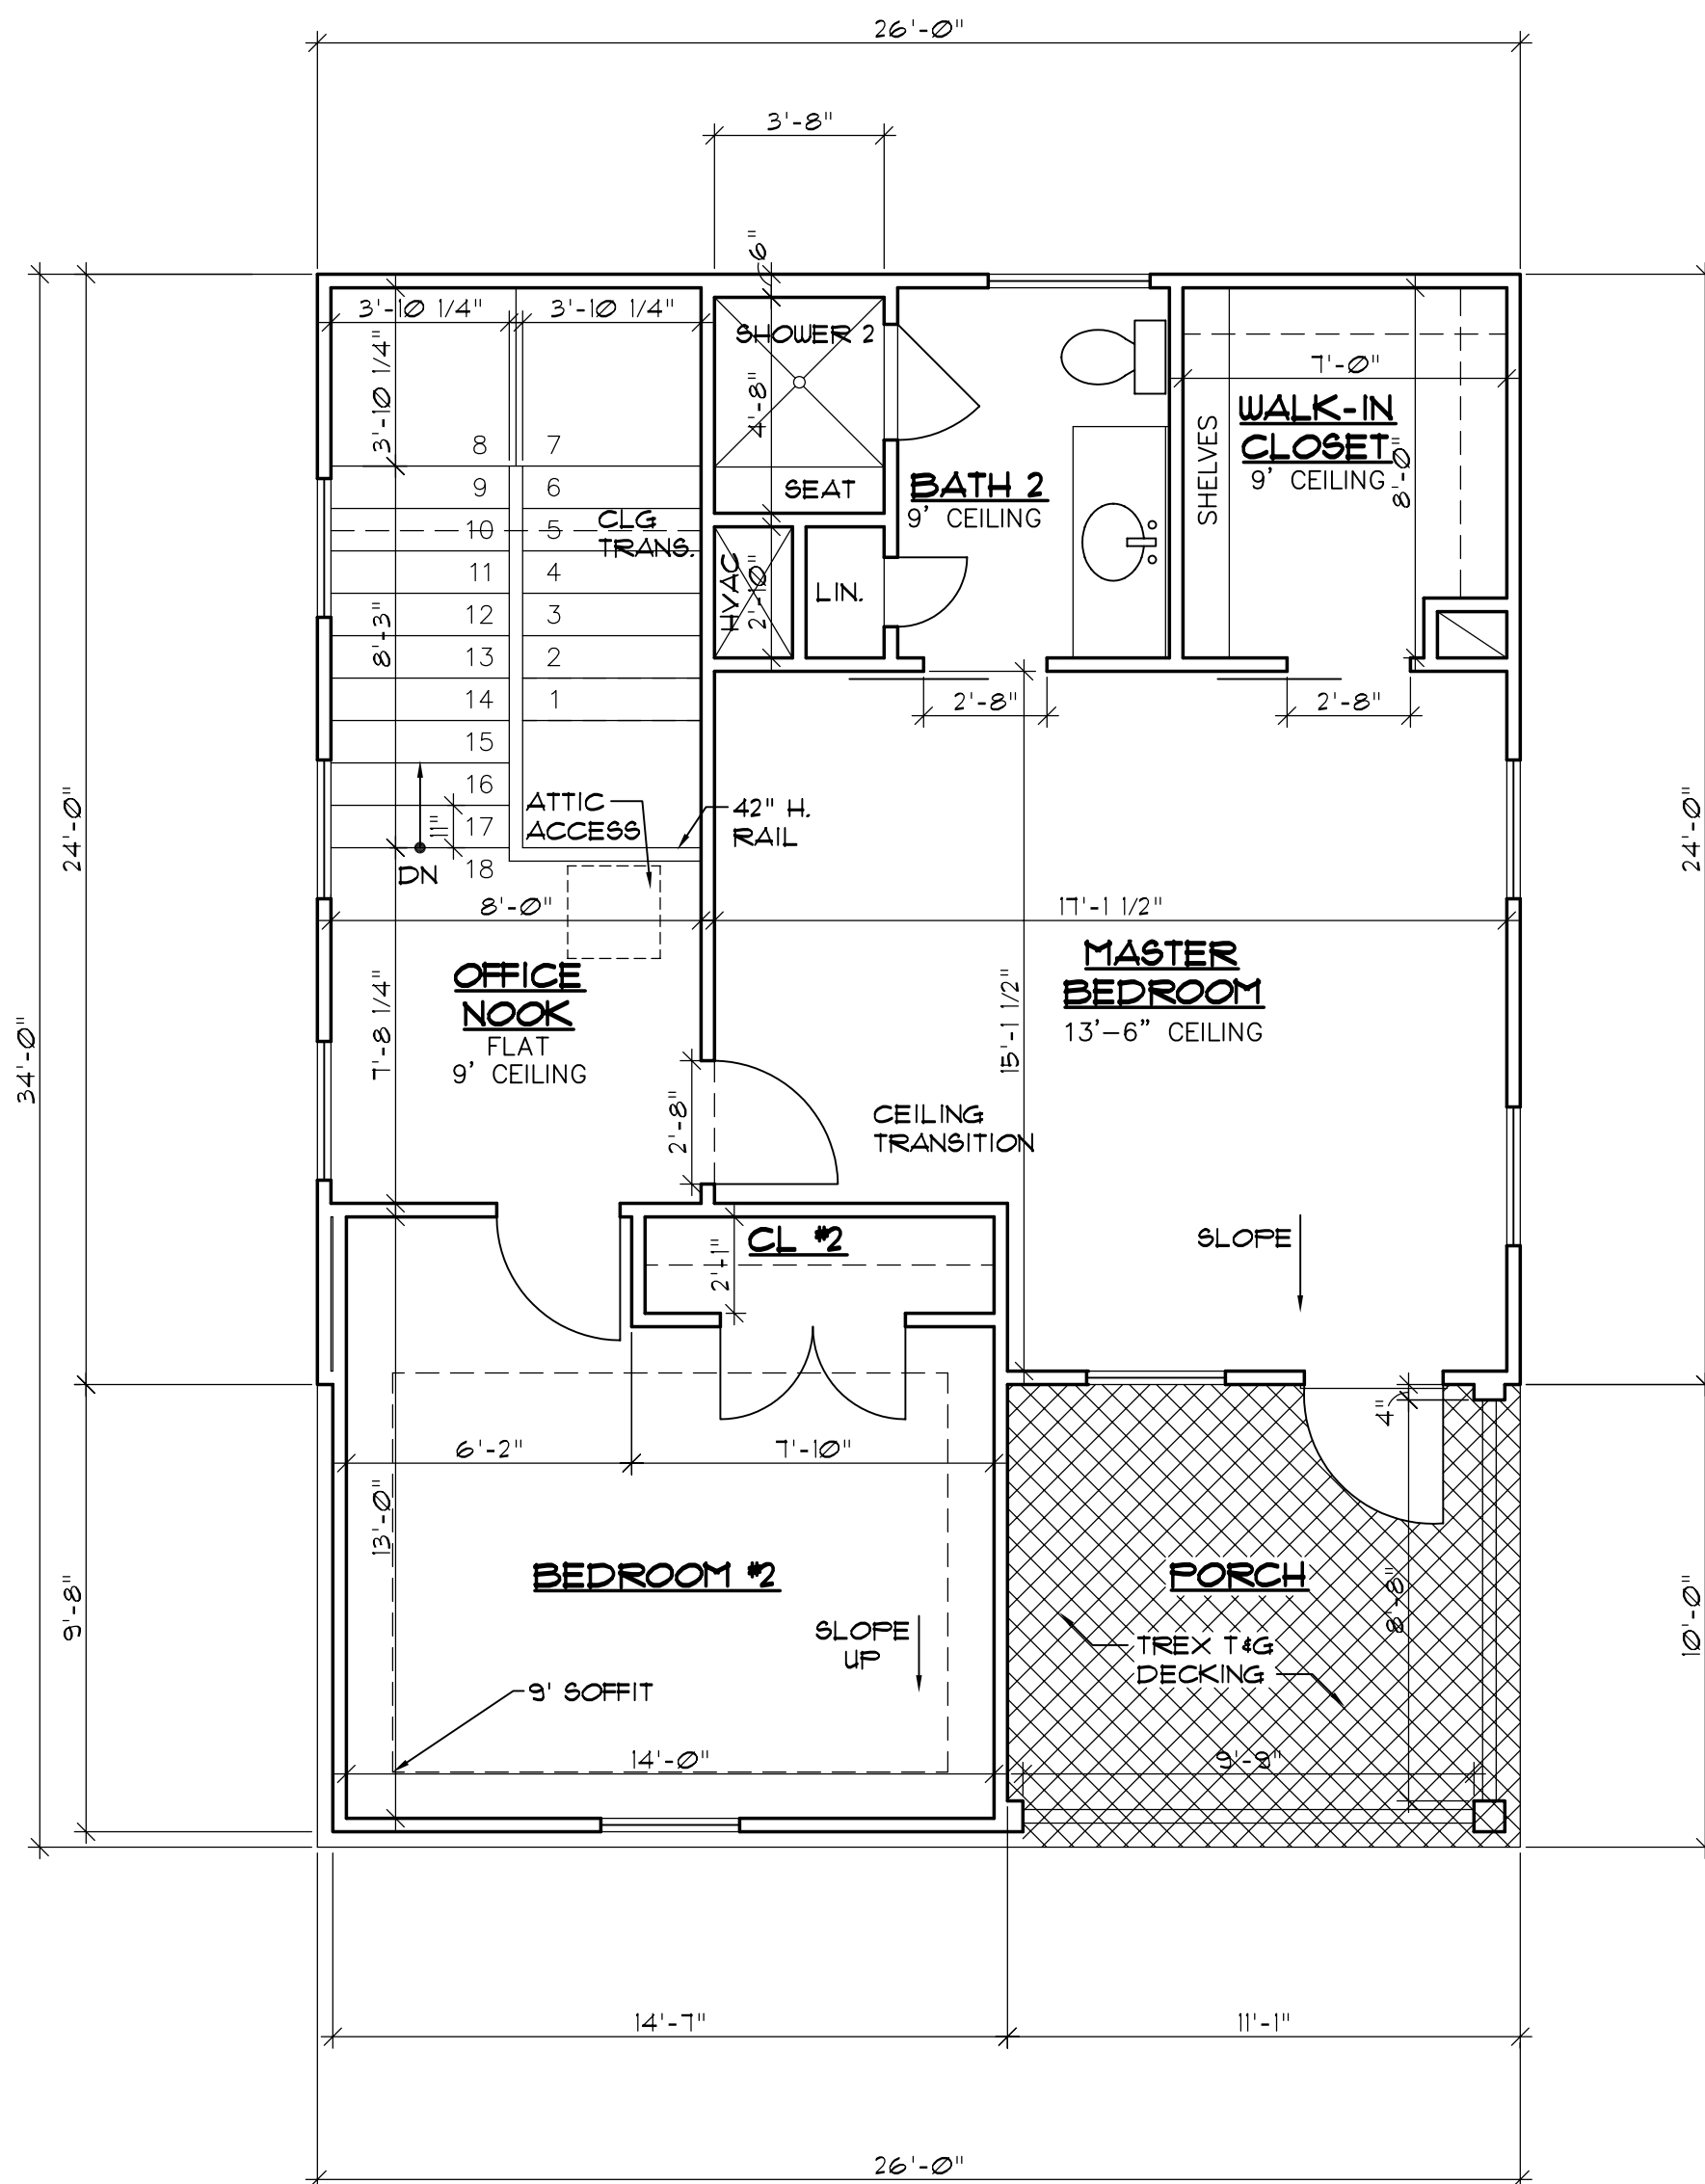

2ND FL. HEATED = 765 SF.  
PORCH = 111 SF.

**2** 2ND LEVEL FLOOR PLAN  
SCALE: 1/4" = 1'-0"

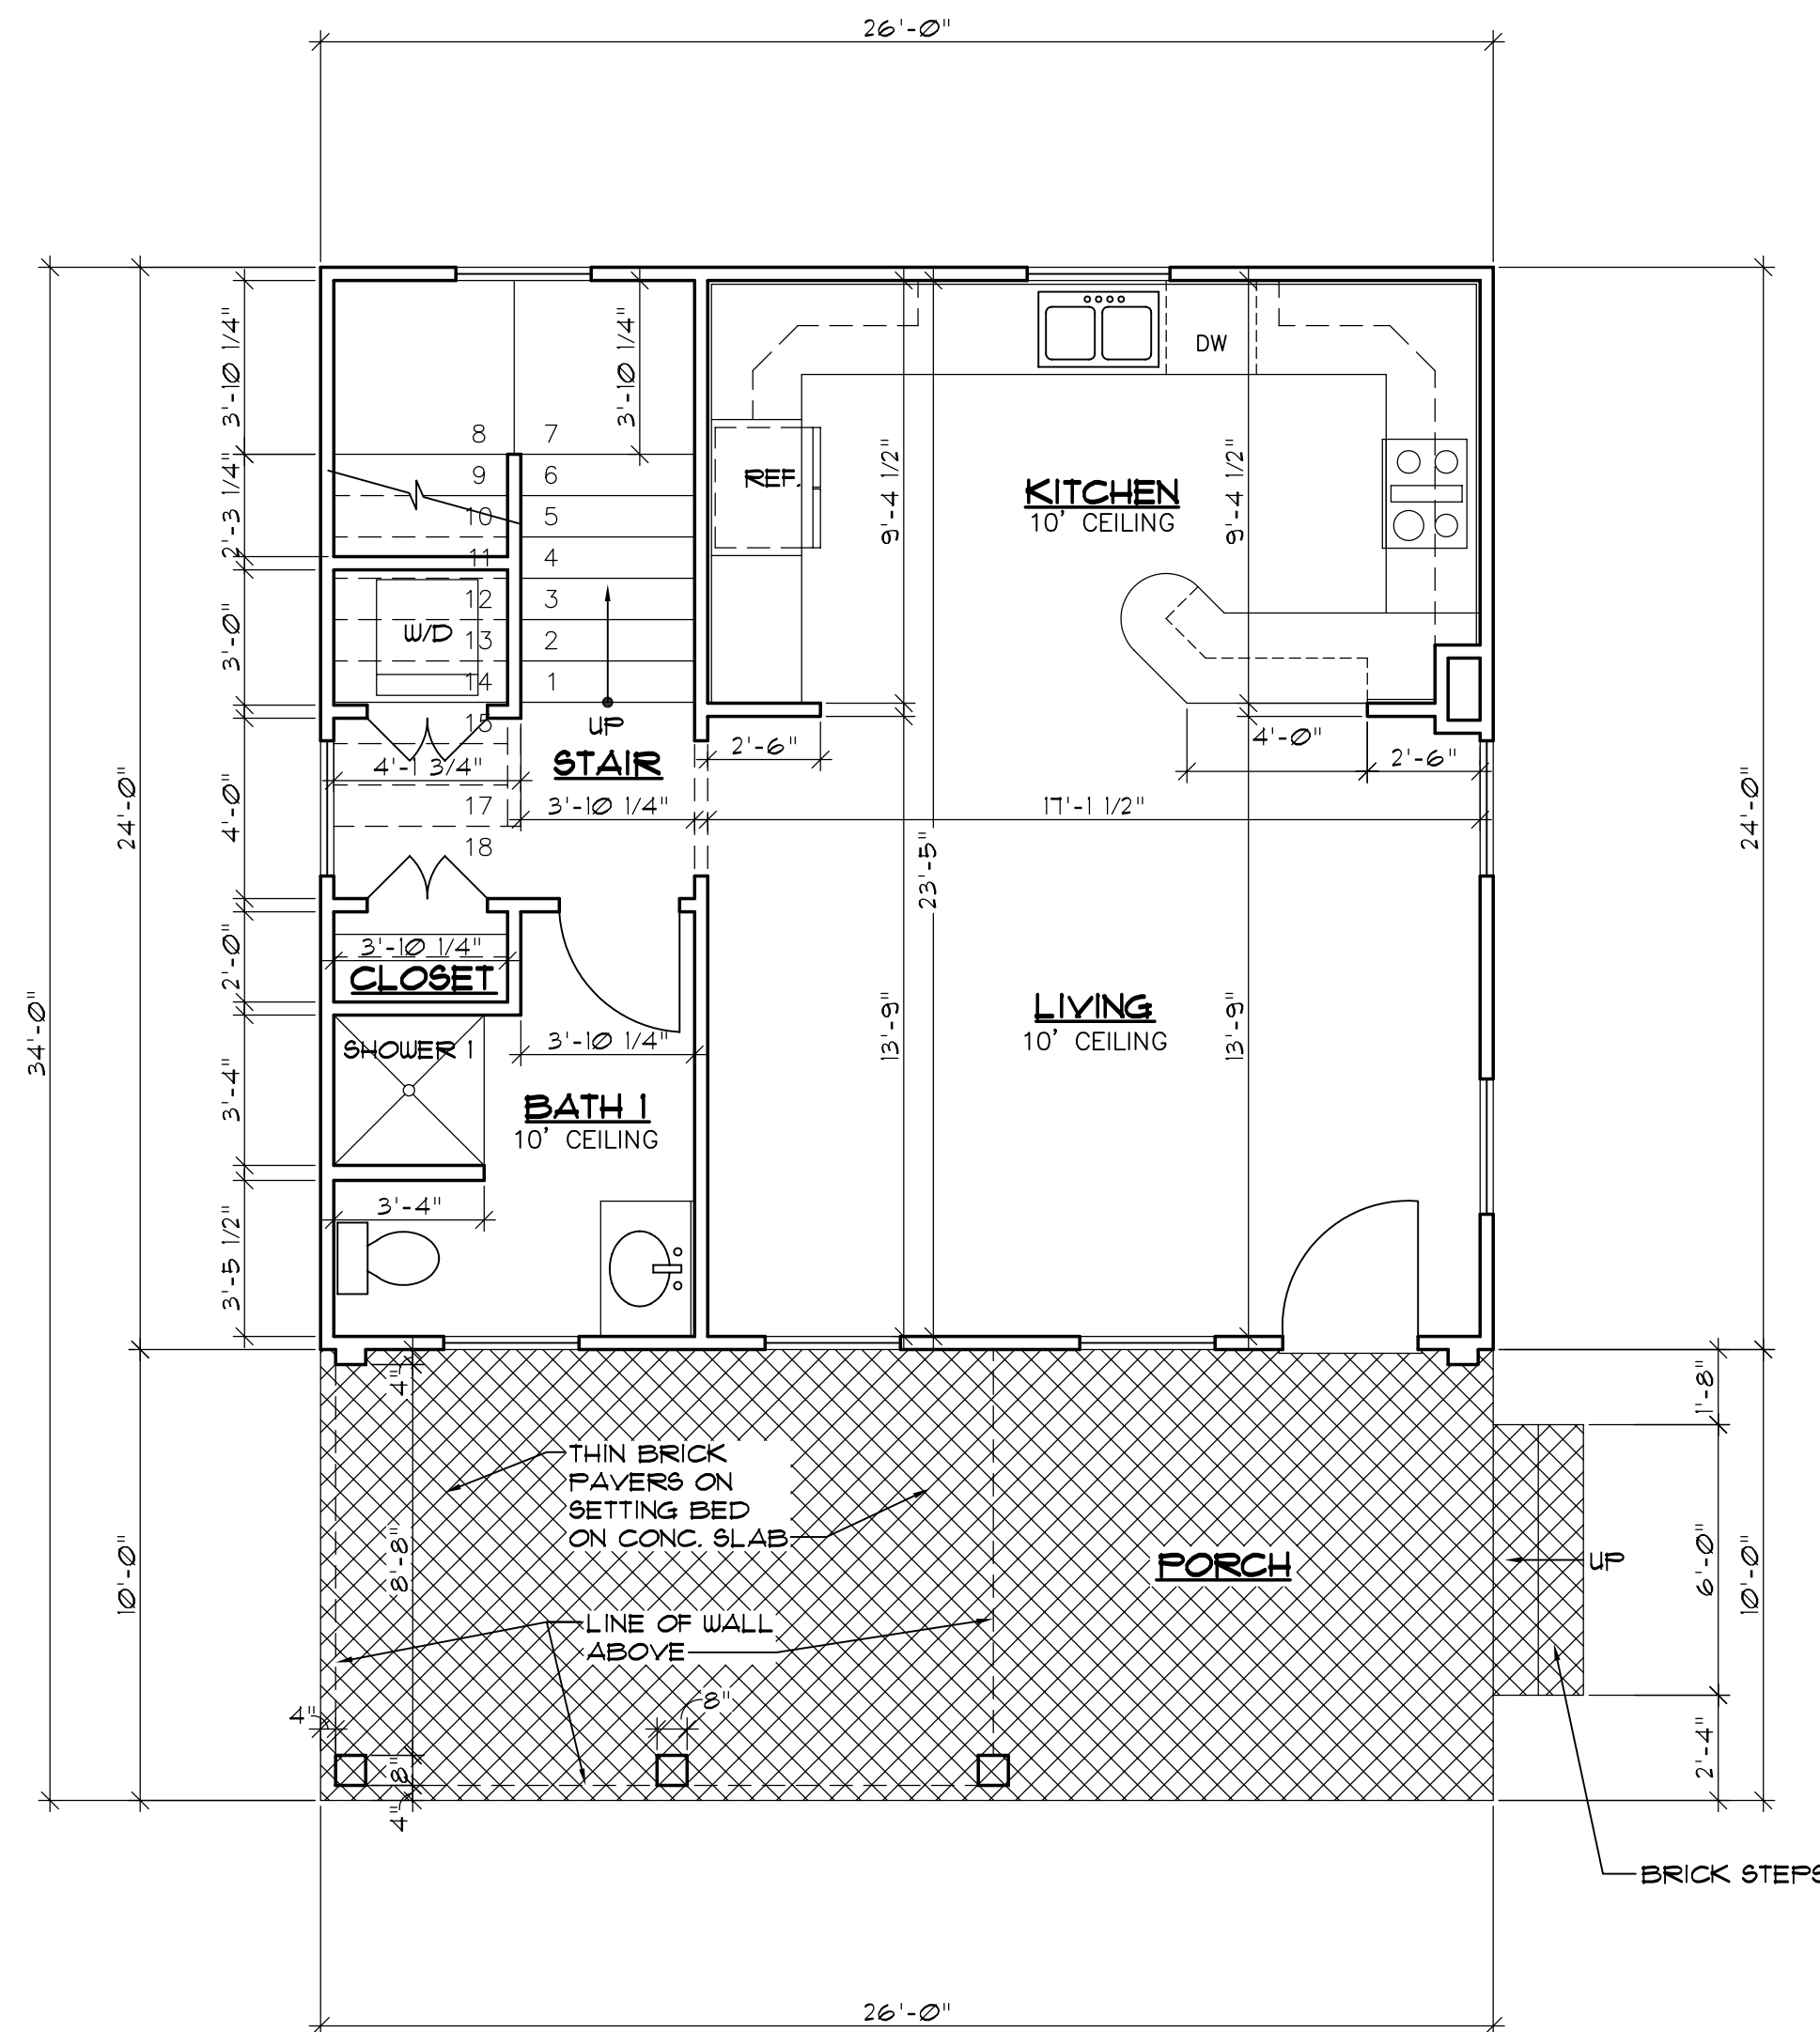


1ST FL. HEATED = 624 SF.  
PORCH = 260 SF.

**1** 1ST LEVEL FLOOR PLAN  
SCALE: 1/4" = 1'-0"

UNIT 1002  
**LEGEND:**  
LIMITED COMMON ELEMENT


THESE DRAWINGS REPRESENT CONDO CERTIFICATION DOCUMENTS. (REFERENCE IS ALSO GIVEN TO ORIGINAL DRAWINGS DATED 15 SEPT. 14 BY COASTAL ARCHITECTURE.) THE UNDERSIGNED REGISTERED ARCHITECT CERTIFIES THAT BUILDING UNITS SHOWN HERE REPRESENTS THE LAYOUT, LOCATION, CEILING AND FLOOR ELEVATIONS, UNIT NUMBERS AND DIMENSIONS OF THE UNITS AS BUILT. DIMENSIONS VERIFIED ARE WITHIN NORMAL EXPECTED CONSTRUCTION TOLERANCES. IT IS FURTHER STATED THAT SUCH PLANS CONTAIN THE INFORMATION REQUIRED BY NCGS 41C-2-109.

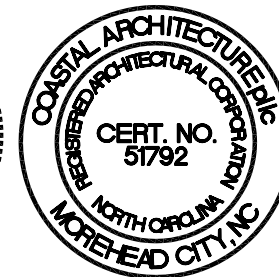

LEE D. DIXON, JR., AIA  
COASTAL ARCHITECTURE, PLLC


**Coastal**  
Architecture  
Architectural  
Design

Lee D. Dixon, Jr., AIA  
252-247-2127  
lee@coastalarchitecture.net  
4206 Bridges St. Ext.,  
Suite C  
Morehead City, NC  
28557

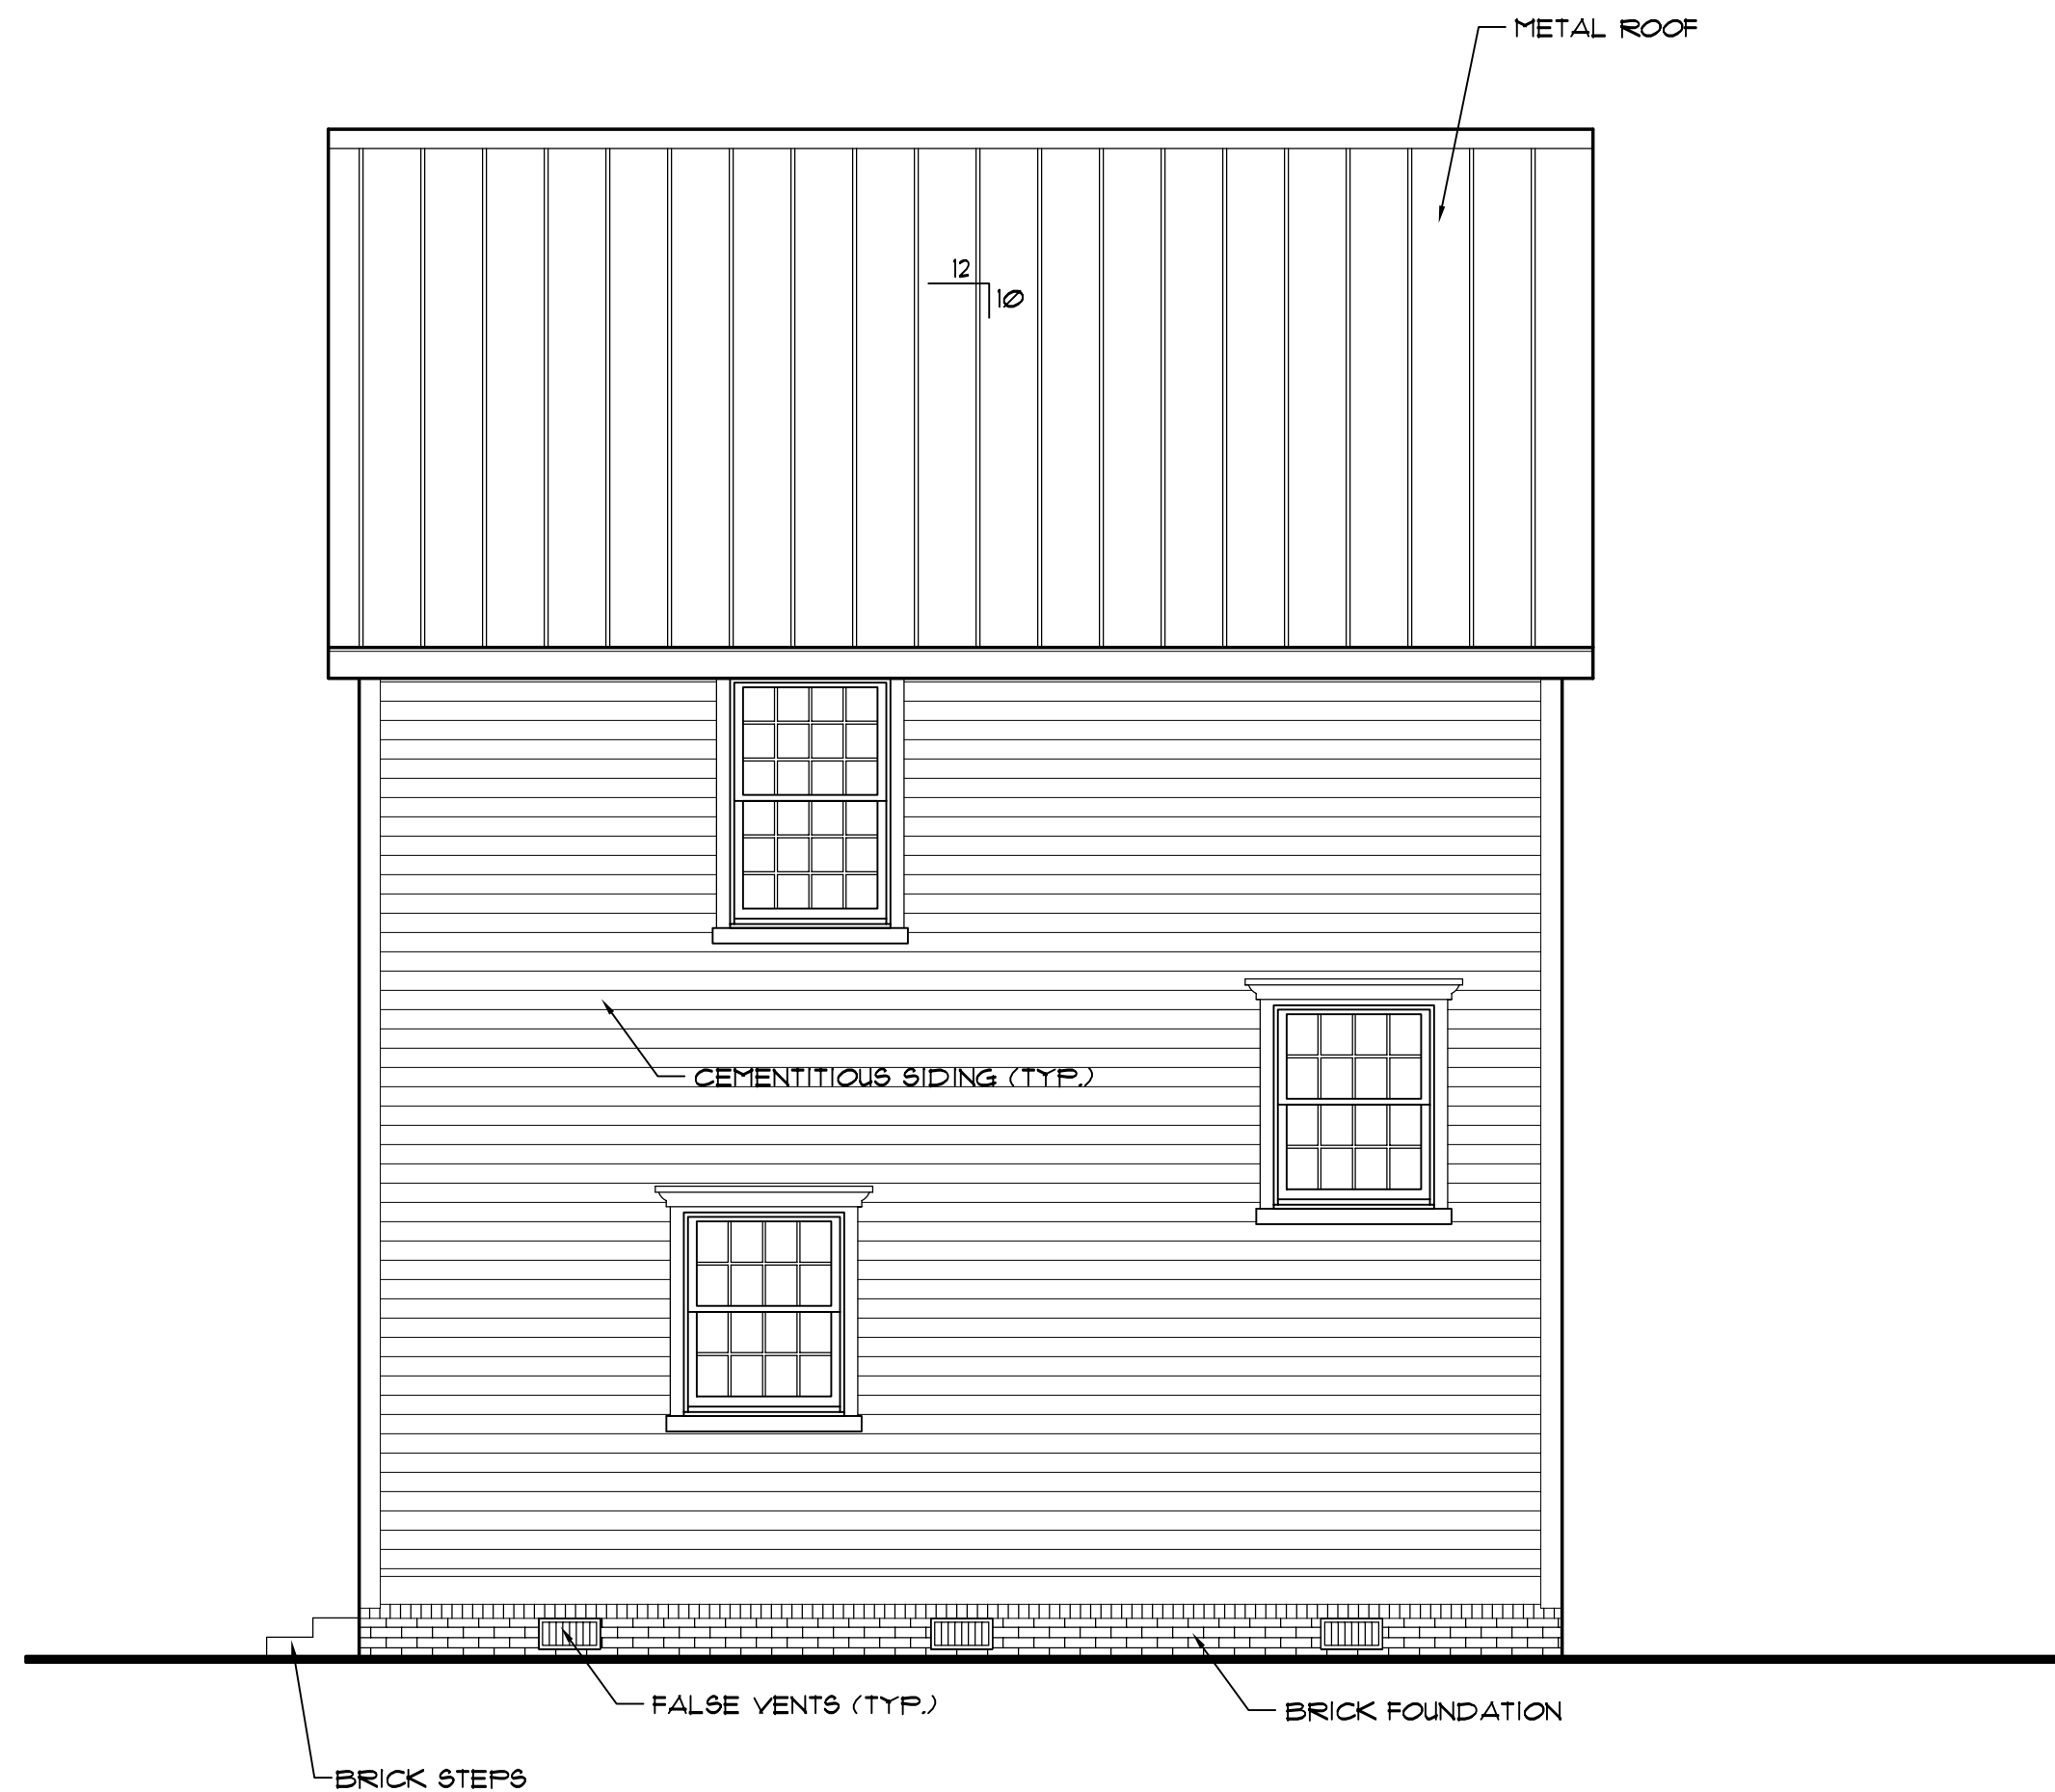

2 REAR ELEVATION  
2 SCALE: 1/4" = 1'-0"

UNIT 1002

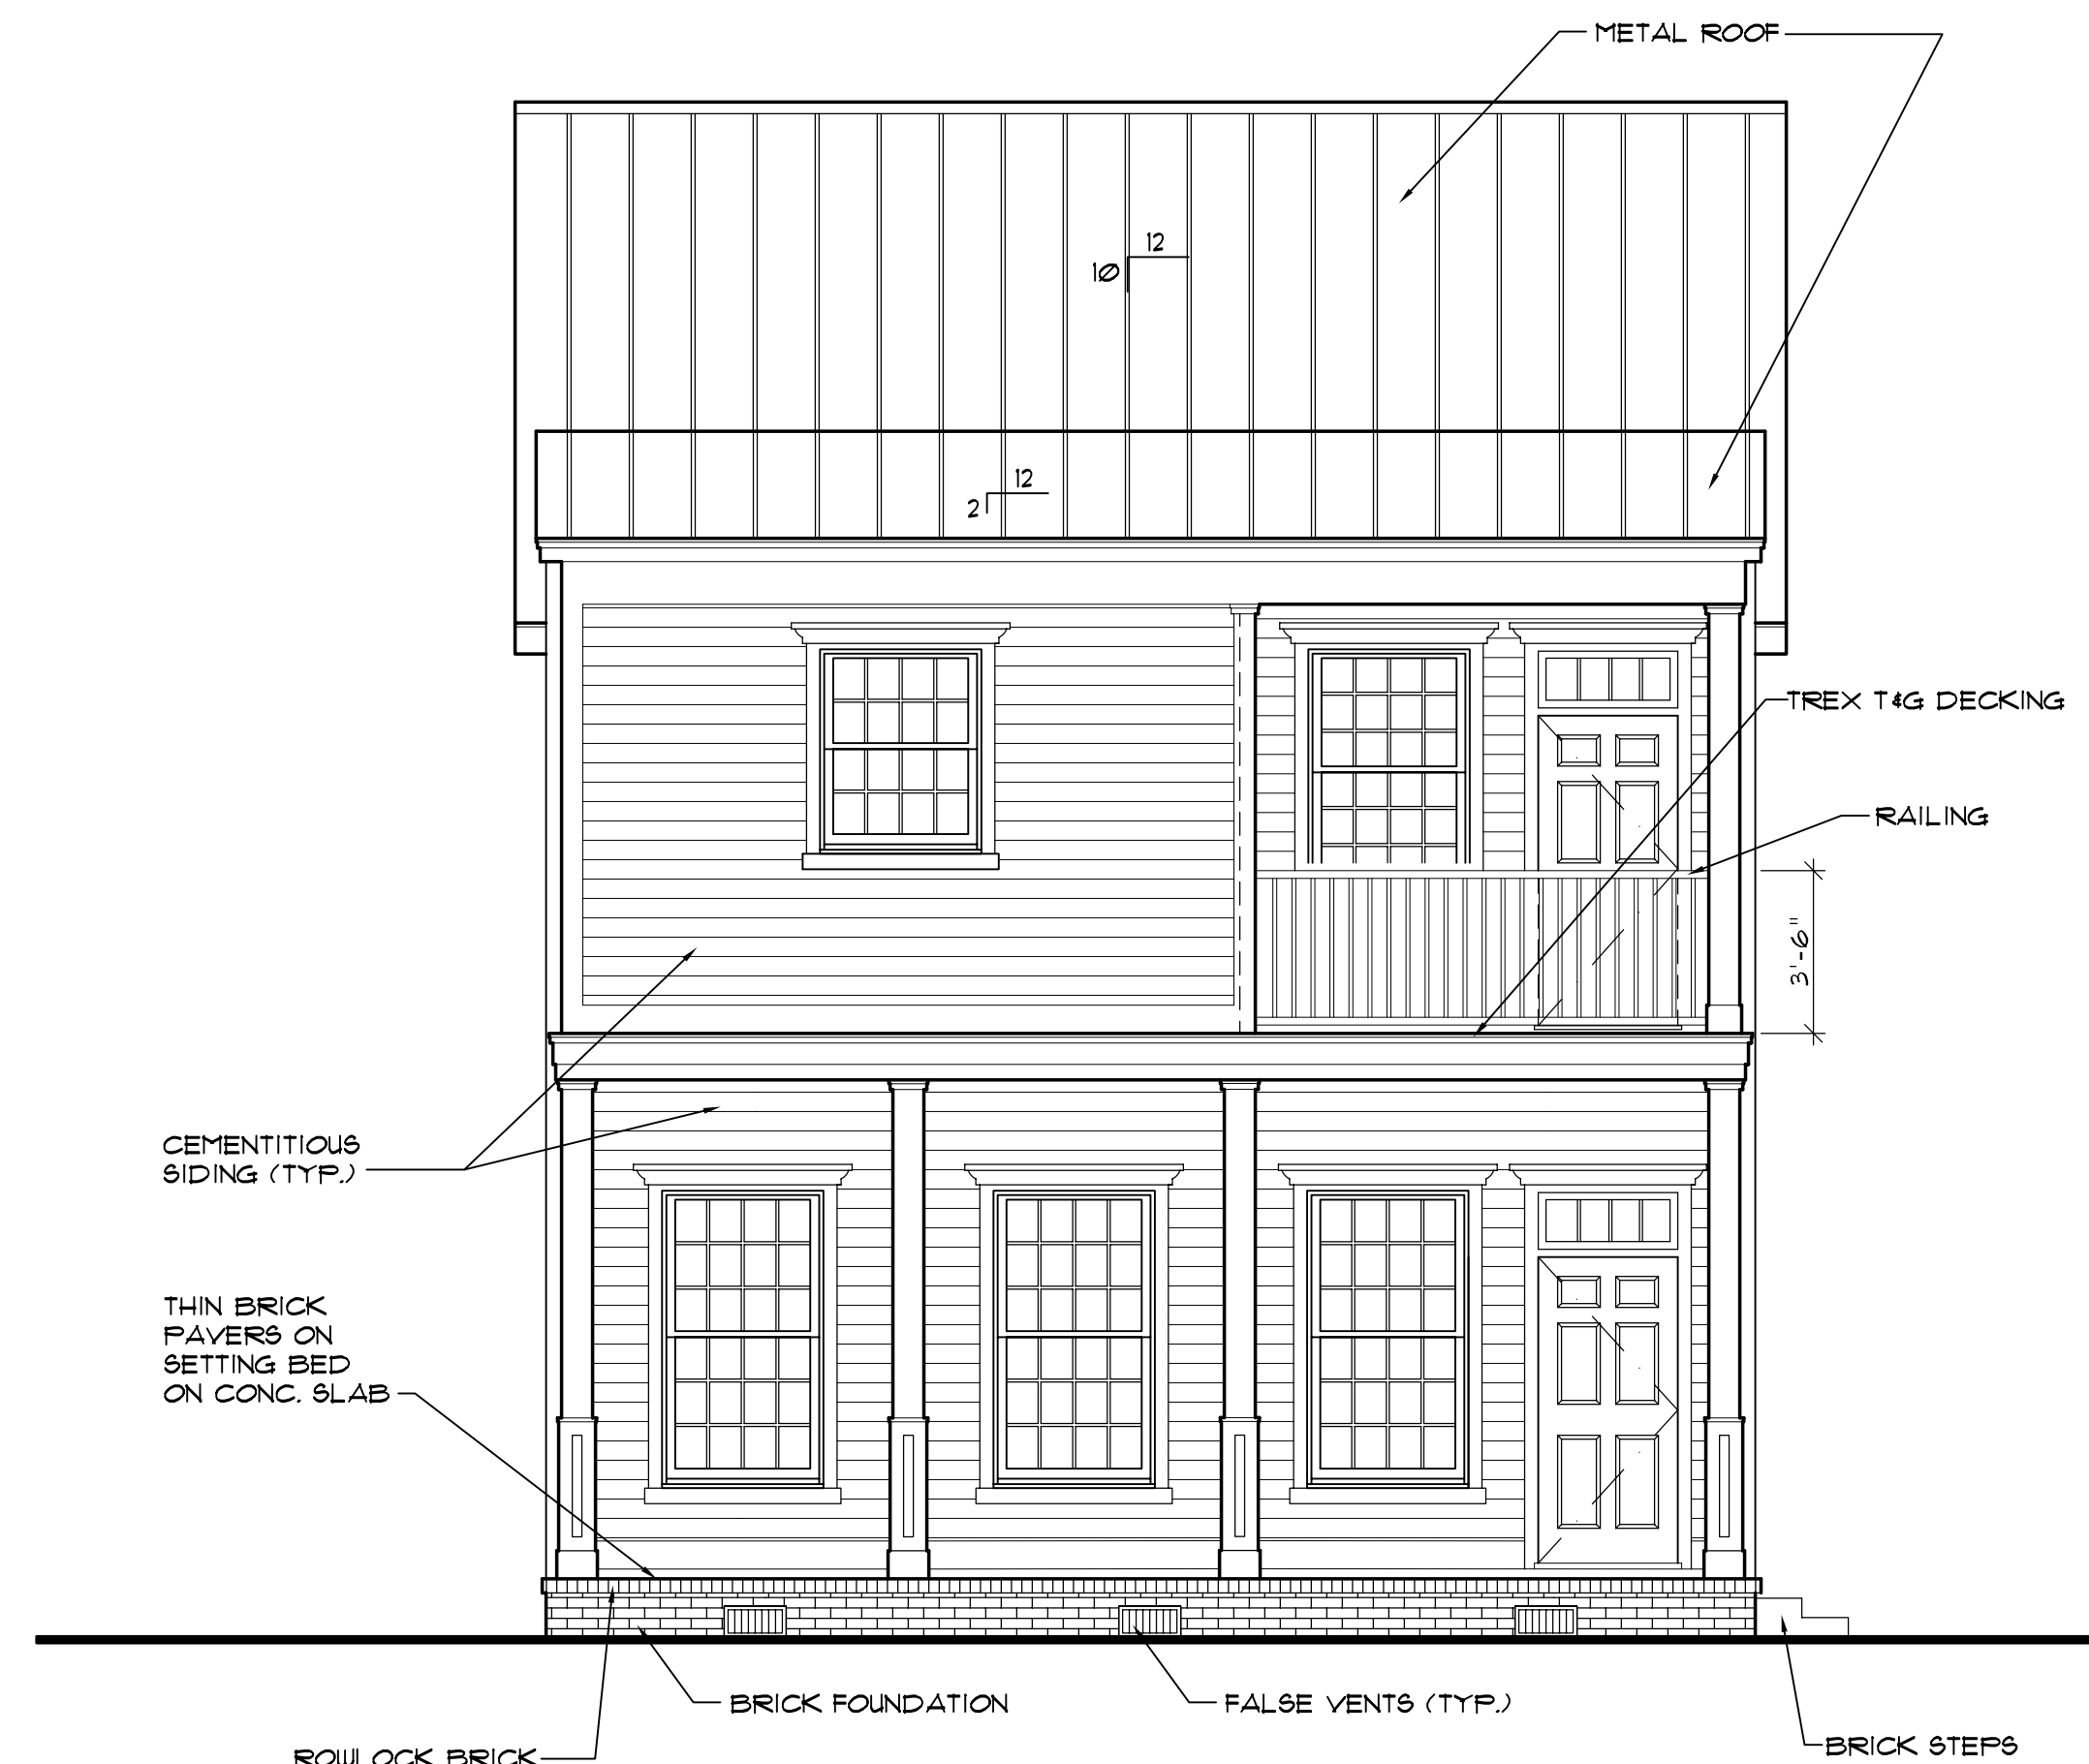

1 FRONT ELEVATION  
2 SCALE: 1/4" = 1'-0"



FRONT STREET VILLAGE PHASE II  
'LIGHT KEEPER'S COTTAGE'  
BEAUFORT, NORTH CAROLINA

16013

ISSUED: 12 MAY 16  
DWG BY: MLR, MES  
CKD BY: LDD  
REVISIONS

SHEET NO.  
2  
OF

THESE DRAWINGS REPRESENT CONDO CERTIFICATION DOCUMENTS. (REFERENCE IS ALSO GIVEN TO ORIGINAL DRAWINGS DATED 15 SEPT. 14 BY COASTAL ARCHITECTURE.) THE UNDERSIGNED REGISTERED ARCHITECT CERTIFIES THAT BUILDING UNITS SHOWN HERE REPRESENTS THE LAYOUT, LOCATION, CEILING AND FLOOR ELEVATIONS, UNIT NUMBERS AND DIMENSIONS OF THE UNITS AS BUILT. DIMENSIONS VERIFIED ARE WITHIN NORMAL EXPECTED CONSTRUCTION TOLERANCES. IT IS FURTHER STATED THAT SUCH PLANS CONTAIN THE INFORMATION REQUIRED BY NCGS 41C-2-109.

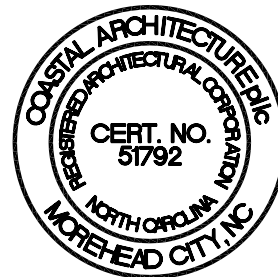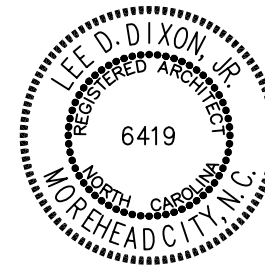


LEE D. DIXON, JR., AIA  
COASTAL ARCHITECTURE PLLC

**FRONT STREET VILLAGE PHASE II**  
**'LIGHT KEEPER'S COTTAGE'**  
BEAUFORT, NORTH CAROLINA


**16013**

ISSUED: 17 MAY 16  
DWG BY: MLR, MES  
CKD BY: LDD  
REVISIONS

SHEET NO.  
**3**  
OF

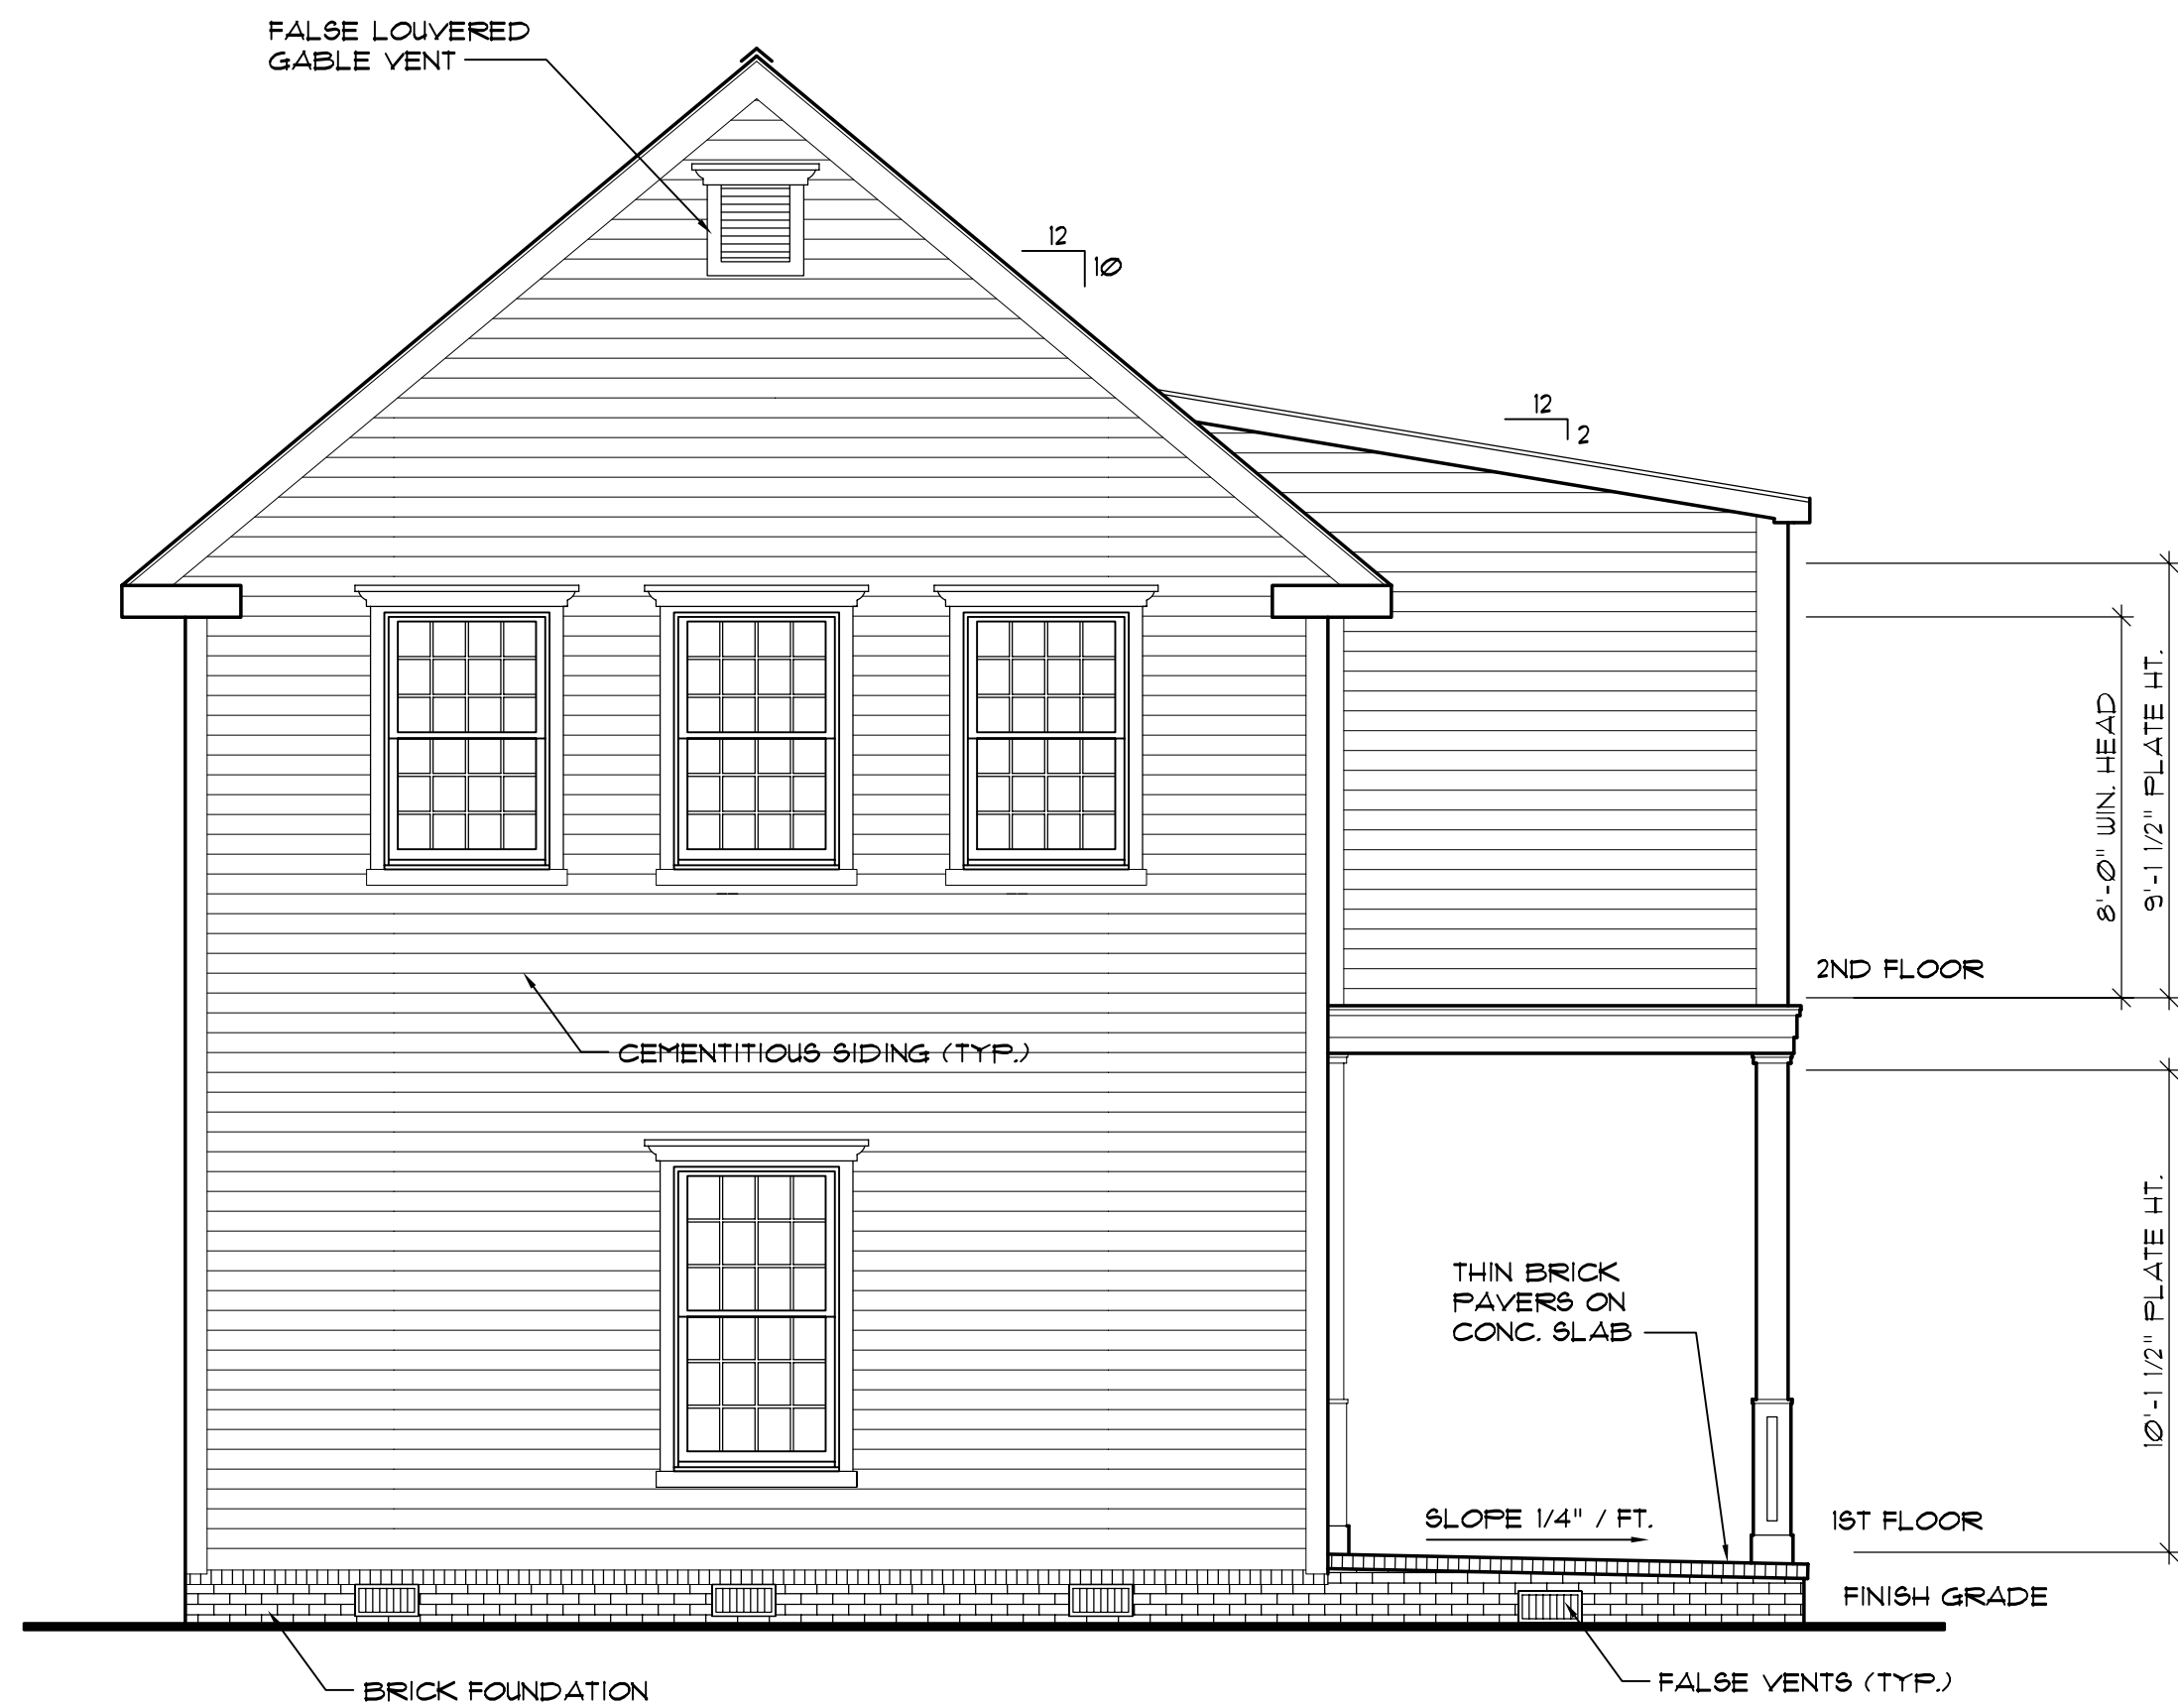

2 LEFT ELEVATION  
3 SCALE: 1/4" = 1'-0"

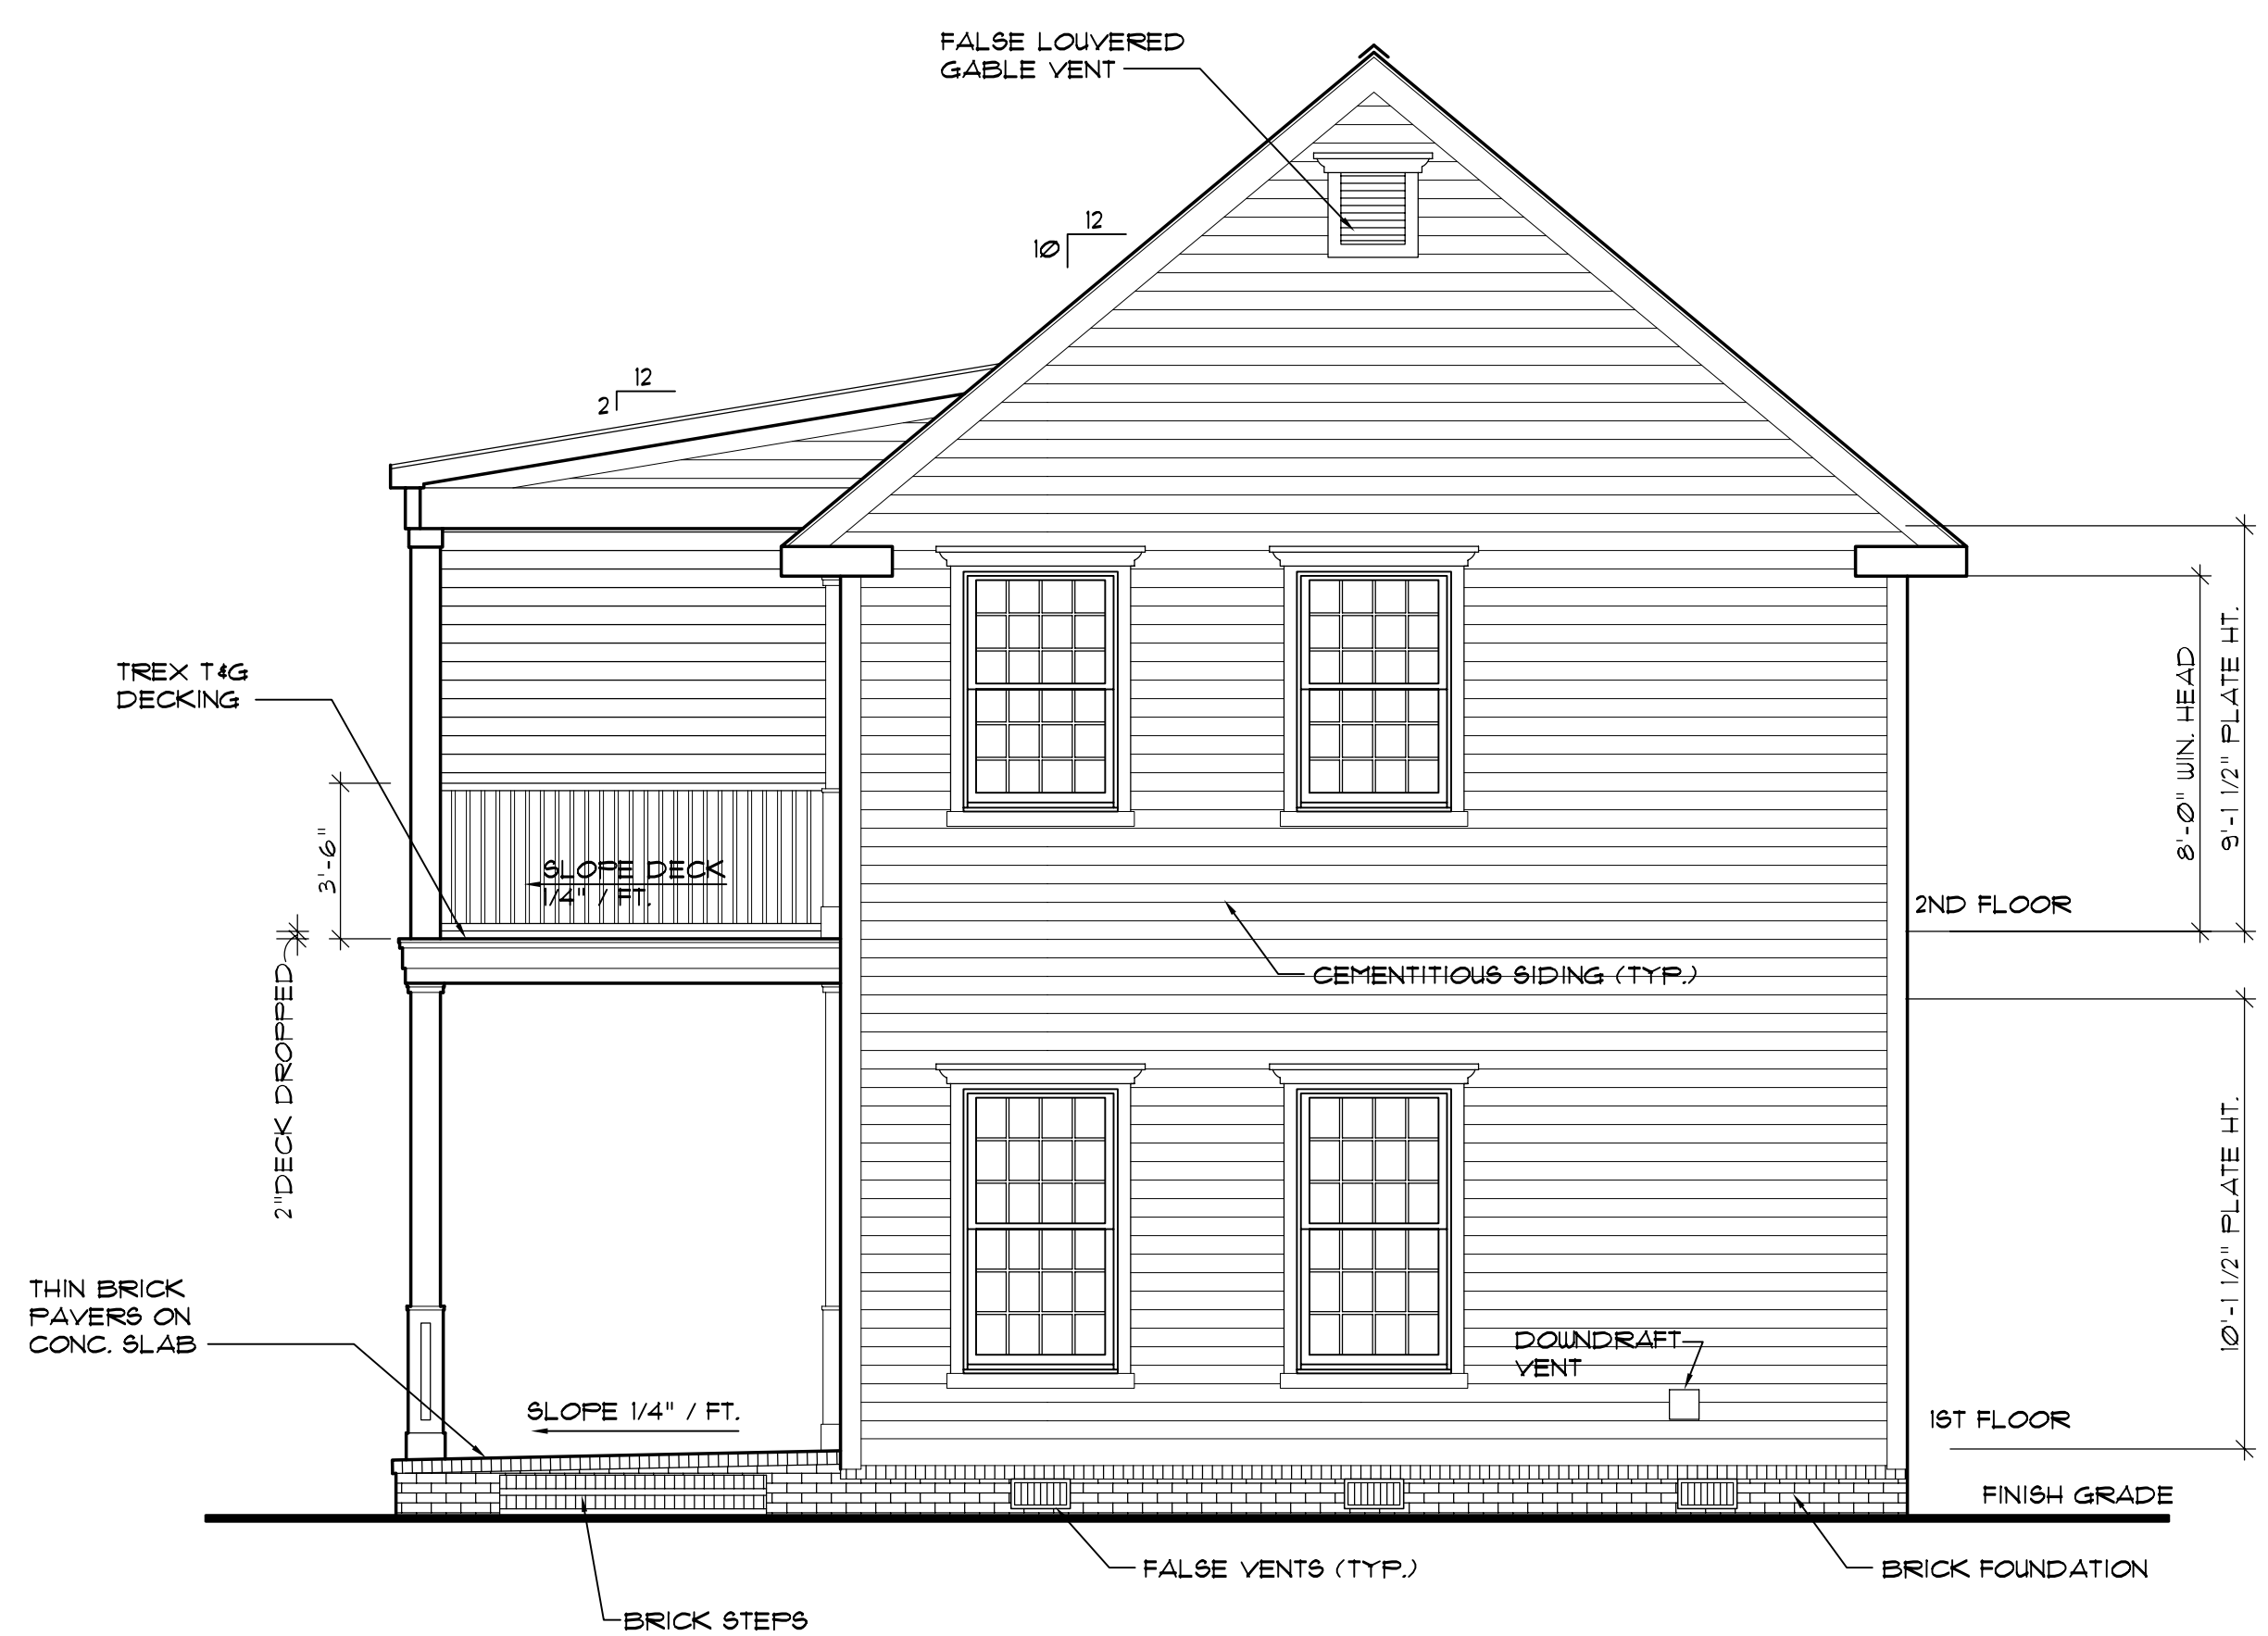

UNIT 1002

1 RIGHT ELEVATION  
3 SCALE: 1/4" = 1'-0"